FED. SUP CLASS
6620

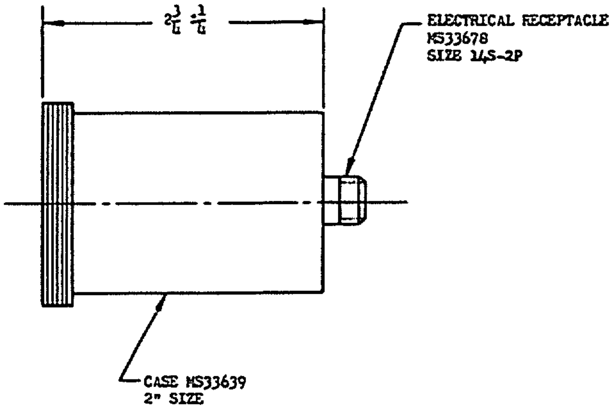

MS PART NO.	FUNCTION	RANGE	PROCUREMENT SPECIFICATION	USED WITH TRANSMITTER
MS28010-1	MULTI-PURPOSE	0-50 PSI	MIL-I-7085	MS28005-1
MS28010-2 (a)	OIL	0-100 PSI	MIL-I-7086	MS28005-2
MS28010-3	OIL	0-200 PSI	MIL-I-7087	MS28005-3
MS28010-4	FUEL	0-1000 PSI	MIL-I-7088	MS28005-4
MS28010-5	HYDRAULIC	0-4000 PSI	MIL-I-7084	MS28005-5
~~MS28010-6~~	~~MANIFOLD~~	~~10-75 IN. MERCURY~~	~~MIL-I-7089~~	~~MS28005-6~~
MS28010-7	FUEL	0-600 PSI	MIL-I-6301	MS28005-7
MS28010-8 (b)	OIL	0-100 PSI	MIL-I-7086	MS28005-2

*Specification MIL-I-7089 has been cancelled and there is no superseding document.

Ⓓ (a) THE POINTER FINISH AND DIAL MARKINGS SHALL BE FLUORESCENT LUMINESCENT MATERIAL IN ACCORDANCE WITH AF 8988994.

(b) THE POINTER FINISH AND DIAL MARKINGS SHALL BE LUSTERLESS WHITE COLOR NO. 37875 OF FED-STD-595.

DIMENSIONS IN INCHES.

CERTAIN PROVISIONS (DIAL DIMENSIONS AND GRADUATIONS) OF THIS STANDARD ARE THE SUBJECT OF INTERNATIONAL STANDARDIZATION AGREEMENT ABC 10/28. WHEN REVISION OR CANCELLATION OF THIS STANDARD IS PROPOSED, THE DEPARTMENTAL CUSTODIANS WILL INFORM THEIR RESPECTIVE DEPARTMENTAL STANDARDIZATION OFFICE SO APPROPRIATE ACTION MAY BE TAKEN RESPECTING THE INTERNATIONAL AGREEMENT CONCERNED.

FOR DESIGN FEATURE PURPOSES, THIS STANDARD TAKES PRECEDENCE OVER PROCUREMENT DOCUMENTS REFERENCED HEREIN. REFERENCED DOCUMENTS SHALL BE OF THE ISSUE IN EFFECT ON DATE OF INVITATIONS FOR BID.

APPROVED 29 Jan 51 REVISED Ⓐ 29 Feb 52 Ⓑ 21 Dec 65 Ⓒ 18 JUN 1975 Ⓓ 29 Feb 92

DISTRIBUTION STATEMENT A. Approved for public release; distribution is unlimited.

AMSC - NA

This military standard is approved for use by all Departments and Agencies of the Department of Defense. Selection for all new engineering and design applications and for repetitive use shall be made from this document when applicable.

Review activities:
Navy - AS
Army - AV

User activities:

P.A. USAF-71 Other Cust Navy - AS Army - EL AF - 99	INTERNATIONAL INTEREST	TITLE INDICATORS, PRESSURE - SYNCHRO, SINGLE, 2-INCH SIZE	MILITARY STANDARD MS28010
PROCUREMENT SPECIFICATION SEE TABLE		SUPERSEDES:	SHEET 1 OF 1

DD FORM 1 SEP 67 672-1 (Coordinated)

PREVIOUS EDITIONS OF THIS FORM ARE OBSOLETE.

(Project No. 6620-0496)

Rev. B

		DATE
DRAWN BY	GAB	13 OCT 65
TYPED BY		
CHECKED BY		

NOTES TO PRINTER: REDUCE BORDER TO 6-27/32x9-3/4. PRINT LEFT BORDER-LINE ONE INCH FROM LEFT EDGE OF 8x10-1/2 SHEET. PRINT BOTTOM BORDER LINE 3/8 INCH FROM BOTTOM EDGE OF 8x10-1/2 SHEET. SIGNATURE FORM NOT TO BE INCLUDED ON 8x10-1/2 SHEET.

GPO 915473

Source: https://assist.dla.mil -- Downloaded: 2026-10-28T16:55Z
Check the source to verify that this is the current version before use.