FED. SUP CLASS
6610

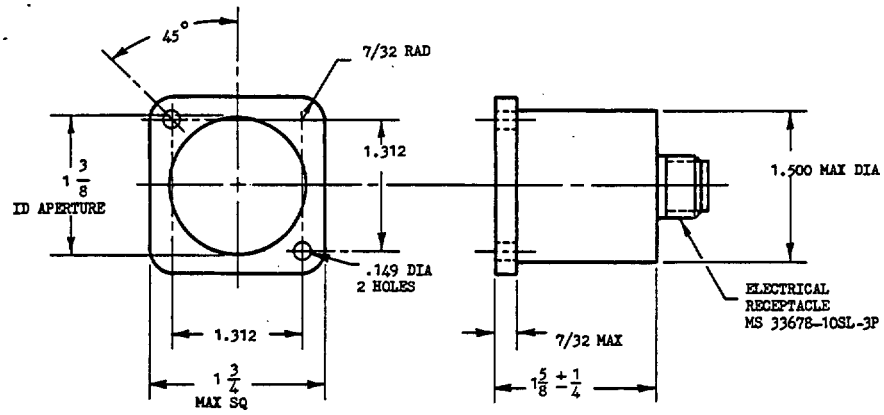

MS PART NO.	FUNCTION	PROCUREMENT SPECIFICATION
MS28002-1	RUDDER TRIM TAB	MIL-I-7063
© ~~MS28002-2~~	~~ELEVATOR TRIM TAB~~	~~MIL-I-7064~~
MS28002-3	AILERON TRIM TAB	MIL-I-7065

DIMENSIONS IN INCHES. UNLESS OTHERWISE SPECIFIED, TOLERANCES: DECIMALS ±.005, FRACTIONS ±1/64, ANGLES ±1/2 .

INACTIVE FOR NEW DESIGN AFTER 20FEBRUARY 1959.
© ~~USE MS33638.~~ MS28002-2 CANCELLED WITH NO REPLACEMENT.

REDRAWN

(D) Cancelled ..... No Superseding Documents.

APPROVED REVISED (B) 05 APR 76 (C) 25 AUGUST 1981 (D) 29 December 1989

DISTRIBUTION STATEMENT A. Approved for public release; distribution is unlimited.

P.A. AIR FORCE-99 Other Cust ARMY - AV NAVY - AS AMSC N/A	TITLE INDICATOR, POSITION, CONTROL SURFACES, 1-3/8 INCH DIAL, 28 VOLTS DC	MILITARY STANDARD MS28002
PROCUREMENT SPECIFICATION SEE ABOVE	SUPERSEDES:	SHEET 1 OF 1

DD FORM 1 SEP 63 672-1

EDITION OF 1 SEP 57 MAY BE USED.

PROJECT NUMBER: 6610-0296

DATE

DRAWN BY Howard Jones 17MAR76

TYPED BY

CHECKED BY

NOTES TO PRINTER: REDUCE BORDER TO 6-27/32x9-3/4. PRINT LEFT BORDER-LINE ONE INCH FROM LEFT EDGE OF 8x10-1/2 SHEET. PRINT BOTTOM BORDER LINE 3/8 INCH FROM BOTTOM EDGE OF 8x10-1/2 SHEET. SIGNATURE FORM NOT TO BE INCLUDED ON 8x10-1/2 SHEET.

Source: https://assist.dla.mil -- Downloaded: 2026-10-23T16:55Z
Check the source to verify that this is the current version before use.