

THE REQUIREMENTS FOR ACQUIRING THE PRODUCT(S) DESCRIBED HEREIN SHALL CONSIST OF THIS SPECIFICATION SHEET AND THE ISSUE OF THE FOLLOWING SPECIFICATION LISTED IN THAT ISSUE OF THE DODISS SPECIFIED IN THE SOLICITATION MIL-R-7885

THIS SPECIFICATION IS APPROVED FOR USE BY ALL DEPARTMENTS AND AGENCIES OF THE DEPARTMENT OF DEFENSE

Form approved
OMB No 0704-0188

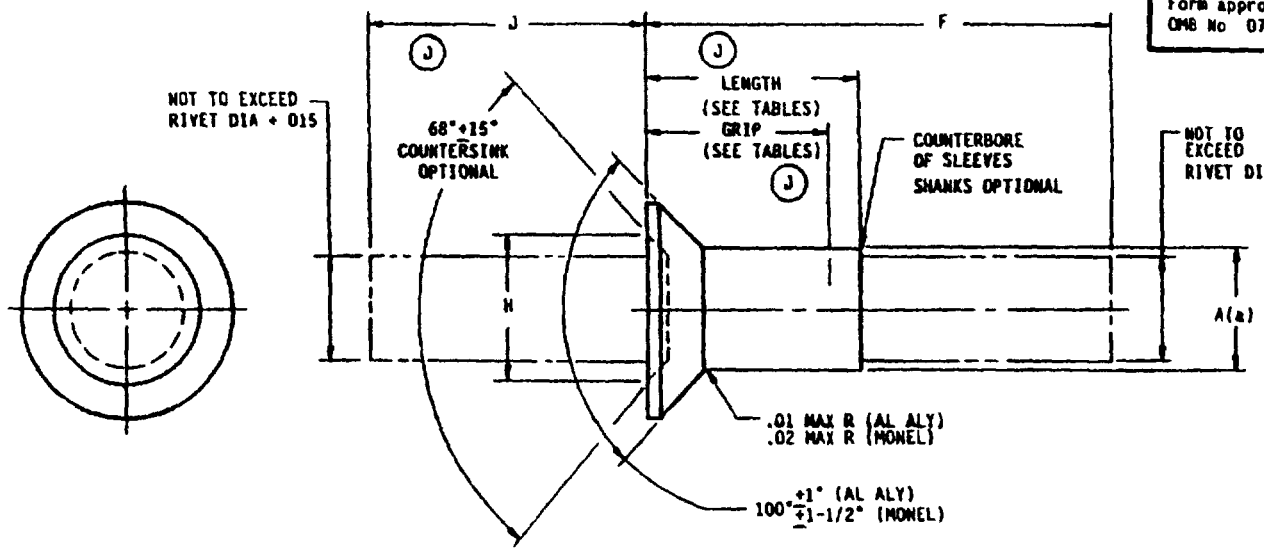

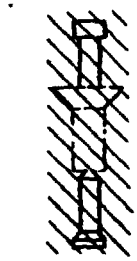


K KNOB STEM



M SERRATED STEM

RIVET IDENTIFICATION CODE

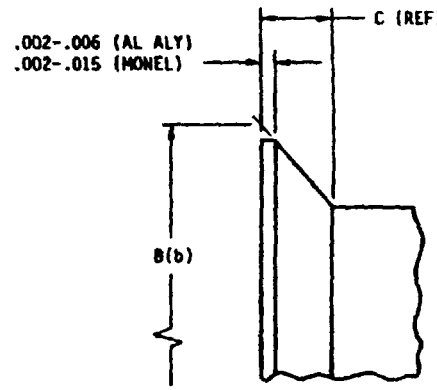

ENLARGED VIEW OF HEAD

(J) TABLE I. DIMENSIONS.

RIVET SIZE NOM DIA	A (a) +.003 -.001 DIA	B (b) +.004 DIA	C (REF)	H MAX DIA	J MIN
1/8	.125	.225	.042	.110	0.750
5/32	.156	.286	.055	.138	0.750
3/16	.187	.353	.070	.161	0.750
1/4	.250	.225	.095	.215	1.000

(a) .001 SHANK DIAMETER INCREASE PERMISSIBLE WITHIN .100 INCH OF BASE HEAD.
(b) MAXIMUM HEAD DIAMETERS ARE TO THEORETICAL SHARP CORNERS AS MEASURED BY PROJECTION.

(J) DENOTES CHANGES

PREPARING ACTIVITY NAVY-AS CUSTODIANS ARMY-AR NAVY- AIR FORCE-99 DLA- REVIEW ARMY-ER, AV, MI NAVY-SH DLA-IS AIR FORCE 82 PROJECT NUMBER 5320-0770	MILITARY SPECIFICATION SHEET TITLE RIVET, BLIND, STRUCTURAL PULL STEM, SELF-PLUGGING, 100° FLUSH HEAD, TYPE II	SPECIFICATION SHEET NUMBER MS20601 10 AUG 92 REV J SUPERSEDING MS20601, REV H, 11 DEC 89 AMSC- N/A FSC 5320

DISTRIBUTION STATEMENT A. Approved for public release; distribution is unlimited.

Source: https://assist.dla.mil -- Downloaded: 2026-10-23T14:23Z
Check to verify that this is the current version before use.

Form approved
OMB No. 0704-0188

W-SERRATED STEM

(J) TABLE II 1/8 RIVET DIAMETER (NOMINAL), PART NUMBERS AND DIMENSIONS

2117 AL	5056 AL	MONEL	MONEL, CADMIUM PLATED				
DASH NO.	DASH NO.	DASH NO.	DASH NO.	GRIP RANGE MIN	GRIP RANGE MAX	LENGTH MAX	F MAX
AD4W1	B4W1	M4W1	MP4W1	UP TO .062		.170	.500
AD4W2	B4W2	M4W2	MP4W2	.063	.125	.232	.562
AD4W3	B4W3	M4W3	MP4W3	.126	.187	.295	.750
AD4W4	B4W4	M4W4	MP4W4	.188	.250	.357	.812
AD4W5	B4W5	M4W5	MP4W5	.251	.312	.420	1.010
AD4W6	B4W6	M4W6	MP4W6	.313	.375	.482	1.072
AD4W7	B4W7	M4W7	MP4W7	.376	.437	.545	1.197
AD4W8	B4W8	M4W8	MP4W8	.438	.500	.607	1.322
AD4W9	B4W9	M4W9	MP4W9	.501	.562	.670	1.509
AD4W10	B4W10	M4W10	MP4W10	.563	.625	.722	1.600
AD4W11	B4W11	M4W11	MP4W11	.626	.687	.785	1.730
AD4W12	B4W12	M4W12	MP4W12	.688	.750	.847	1.820

(J) TABLE III 5/32 RIVET DIAMETER (NOMINAL), PART NUMBERS AND DIMENSIONS

2117 AL	5056 AL	MONEL	MONEL, CADMIUM PLATED				
DASH NO.	DASH NO.	DASH NO.	DASH NO.	GRIP RANGE MIN	GRIP RANGE MAX	LENGTH MAX	F MAX
AD5W2	B5W2	M5W2	MP5W2	.065	.125	.254	.620
AD5W3	B5W3	M5W3	MP5W3	.126	.187	.317	.808
AD5W4	B5W4	M5W4	MP5W4	.188	.250	.379	.870
AD5W5	B5W5	M5W5	MP5W5	.251	.312	.441	1.058
AD5W6	B5W6	M5W6	MP5W6	.313	.375	.503	1.120
AD5W7	B5W7	M5W7	MP5W7	.376	.437	.567	1.339
AD5W8	B5W8	M5W8	MP5W8	.438	.500	.629	1.401
AD5W9	B5W9	M5W9	MP5W9	.501	.562	.692	1.567
AD5W10	B5W10	M5W10	MP5W10	.563	.625	.754	1.630
AD5W11	B5W11	M5W11	MP5W11	.626	.687	.817	1.817
AD5W12	B5W12	M5W12	MP5W12	.688	.750	.879	1.880
AD5W13	B5W13	M5W13	MP5W13	.751	.812	.942	2.067
AD5W14	B5W14	M5W14	MP5W14	.813	.875	1.004	2.130

(J) TABLE IV 3/16 RIVET DIAMETER (NOMINAL), PART NUMBERS AND DIMENSIONS.

2117 AL	5056 AL	MONEL	MONEL, CADMIUM PLATED				
DASH NO.	DASH NO.	DASH NO.	DASH NO.	GRIP RANGE MIN	GRIP RANGE MAX	LENGTH MAX	F MAX
AD6W2	B6W2	M6W2	MP6W2	.080	.125	.277	.700
AD6W3	B6W3	M6W3	MP6W3	.126	.187	.340	.888
AD6W4	B6W4	M6W4	MP6W4	.188	.250	.402	.950
AD6W5	B6W5	M6W5	MP6W5	.251	.312	.465	1.138
AD6W6	B6W6	M6W6	MP6W6	.313	.375	.527	1.200
AD6W7	B6W7	M6W7	MP6W7	.376	.437	.590	1.419
AD6W8	B6W8	M6W8	MP6W8	.438	.500	.652	1.481
AD6W9	B6W9	M6W9	MP6W9	.501	.562	.715	1.637
AD6W10	B6W10	M6W10	MP6W10	.563	.625	.777	1.699
AD6W11	B6W11	M6W11	MP6W11	.626	.687	.840	1.887
AD6W12	B6W12	M6W12	MP6W12	.688	.750	.902	1.949
AD6W13	B6W13	M6W13	MP6W13	.751	.812	.965	2 074
AD6W14	B6W14	M6W14	MP6W14	.813	.875	1.027	2.199

(J) TABLE V. 1/4 RIVET DIAMETER (NOMINAL), PART NUMBERS AND DIMENSIONS

2117 AL	5056 AL	MONEL	MONEL, CADMIUM PLATED				
DASH NO.	DASH NO.	DASH NO.	DASH NO.	GRIP RANGE MIN	GRIP RANGE MAX	LENGTH MAX	F MAX
AD8W3	B8W3	M8W3	MP8W3	.125	.187	.385	.968
AD8W4	B8W4	M8W4	MP8W4	.188	.250	.447	1.030
AD8W5	B8W5	M8W5	MP8W5	.251	.312	.510	1.218
AD8W6	B8W6	M8W6	MP8W6	.313	.375	.572	1.280
AD8W7	B8W7	M8W7	MP8W7	.376	.437	.635	1.468
AD8W8	B8W8	M8W8	MP8W8	.438	.500	.697	1.530
AD8W9	B8W9	M8W9	MP8W9	.501	.562	.760	1.718
AD8W10	B8W10	M8W10	MP8W10	.563	.625	.822	1.780
AD8W11	B8W11	M8W11	MP8W11	.626	.687	.885	1.968
AD8W12	B8W12	M8W12	MP8W12	.688	.750	.947	2.030
AD8W13	B8W13	M8W13	MP8W13	.751	.812	1.010	2.218
AD8W14	B8W14	M8W14	MP8W14	.813	.875	1.072	2.280
AD8W15	B8W15	M8W15	MP8W15	.876	.937	1.134	2.405
AD8W16	B8W16	M8W16	MP8W16	.938	1.000	1.198	2.530

PREPARING ACTIVITY NAVY-AS
CUSTODIANS ARMY-AR NAVY-
AIR FORCE-99 DLA-
REVIEW ARMY-ER, AV, MI NAVY-SH DLA-IS
AIR FORCE 82
PROJECT NUMBER 5320-0770

MILITARY SPECIFICATION SHEET

TITLE RIVET, BLIND, STRUCTURAL PULL STEM, SELF-PLUGGING, 100° FLUSH HEAD, TYPE II

SPECIFICATION SHEET NUMBER
MS20601 10 AUG 92
REV J

SUPERSEDING
MS20601, REV H, 11 DEC 89

AMSC N/A FSC 5320

Source: https://assist.dla.mil/ - Downloaded: 2026-10-23 14:23Z
Check the source to verify that this is the current version before use.

FORM APPROVED
OMB NO 0704-0188

(J) REQUIREMENTS:

1. MATERIAL: SLEEVES, AL ALLOY, COMP 2117, QQ-A-430.
AL ALLOY, COMP 5056, QQ-A-430.
NICKEL-COPPER-ALLOY (MONEL), CLASS A, QQ-N-281.
PINS, AL ALLOY, COMP 2017, QQ-A-430.
AL ALLOY, COMP 5056, QQ-A-430.
NICKEL-COPPER-ALLOY (MONEL), CLASS A, QQ-N-281.

2. FINISH: ALUMINUM ALLOY; ANODIZE IN ACCORDANCE WITH MIL-A-8625 OR CHEMICALLY SURFACE TREAT IN ACCORDANCE WITH MIL-C-5541.
NICKEL-COPPER-ALLOY (MONEL); CADMIUM-PLATED IN ACCORDANCE WITH PROCUREMENT SPECIFICATION.

3. COLOR: 5056 ALUMINUM ALLOY RIVETS SHALL BE SUITABLY IDENTIFIED BY AN ORANGE COLOR IN ACCORDANCE WITH FEDERAL STANDARD NUMBER 596, COLOR NUMBER 32246.

4. ADD "AD" IN PLACE OF DASH TO INDICATE ALUMINUM ALLOY, COMPOSITION 2117.
ADD "B" IN PLACE OF DASH TO INDICATE ALUMINUM ALLOY, COMPOSITION 5056.
ADD "M" IN PLACE OF DASH TO INDICATE NICKEL-COPPER-ALLOY (MONEL). ~~INACTIVE FOR DESIGN AFTER 1 FEBRUARY 1960.~~
~~ADD "ML" IN PLACE OF DASH TO INDICATE NICKEL-COPPER-ALLOY (MONEL) SILVER PLATED.~~
ADD "P" AFTER MATERIAL DESIGNATION TO INDICATE CADMIUM PLATE.

5. ~~ADD IDENTIFICATION CODE LETTERS AFTER DASH NUMBERS TO INDICATE TYPE OF RIVET BASED ON METHOD OF INSTALLATION.~~
~~ADD "K" TO INDICATE KNOB STEM RIVET.~~
~~ADD "W" TO INDICATE SERRATED STEM RIVET.~~
~~NO LETTER INDICATES A COMPLETE RIVET WITH TYPE OF STEM OPTIONAL. INACTIVE FOR DESIGN AFTER 21 MARCH 1962. CANCELLED AFTER 1 FEBRUARY 1960.~~

(J) NOTES:

1. EXAMPLES OF PART NUMBERS:
MS20601 ADSW5 = RIVET, 2117 ALUMINUM ALLOY SLEEVE, .156 DIA, SERRATED STEM, .251 TO .312 GRIP RANGE.
MS20601 BSW5 = RIVET, 5056 AL ALLOY SLEEVE, .156 DIA, SERRATED STEM, .251 TO .312 GRIP RANGE.
MS20601 MPSW5 = RIVET, NICKEL-ALLOY (MONEL) SLEEVE, CADMIUM-PLATED, .156 DIA, SERRATED STEM, .251 TO .312 GRIP RANGE.

2. DIMENSIONS ARE IN INCHES, UNLESS OTHERWISE SPECIFIED.

(J) 3. FOR QUALIFIED PRODUCTS, SEE QPL-7885.

4. FOR DESIGN USAGE LIMITATIONS, USE MS33522.

5. SILVER-PLATED NICKEL-COPPER-ALLOY (MONEL) (SERIES ML) RIVETS SHALL BE INACTIVE FOR DESIGN AFTER (DATE). USE EXISTING STOCK UNTIL DEPLETED. USE MONEL (SERIES M) OR CADMIUM-PLATED MONEL (SERIES MP) RIVETS IDENTIFIED BY THE SAME DASH NUMBER. KNOB STEM RIVETS (SERIES K) AND "NO LETTER RIVETS" INACTIVE FOR DESIGN AFTER 21 MARCH 1962, USE MS20601, SHEET 2, SERRATED STEM RIVETS (SERIES W). KNOB STEM RIVETS (SREIES K) WILL BE CANCELLED FROM THIS STANDARD 21 MARCH 1965.

6. INTERCHANGEABILITY RELATIONSHIP: SERRATED STEM RIVETS (SERIES W) ARE UNIVERSALLY, FUNCTIONALLY, AND DIMENSIONALLY INTERCHANGEABLE WITH KNOB STEM RIVETS (SERIES K) WITH PROPER TOOLING.

7. KNOB STEM RIVETS (SERIES K) SHOULD BE USED UNTIL EXISTING STOCK IS DEPLETED.
~~MONEL RIVETS IDENTIFIED BY M INACTIVE FOR DESIGN AFTER 1 FEBRUARY 1960. USE RIVETS IDENTIFIED BY ML (MONEL, SILVER PLATED).~~

8. FOR DESIGN FEATURE PURPOSES, THIS STANDARD TAKES PRECEDENCE OVER PROCUREMENT DOCUMENTS REFERENCED HEREIN. REFERENCED DOCUMENTS SHALL BE OF THE ISSUE IN EFFECT ON DATE OF INVITATIONS FOR BID.

PREPARING ACTIVITY NAVY — AS
CUSTODIANS ARMY — AR NAVY —
AIR FORCE — 99 DLA —
REVIEW: ARMY-ER, AV, MI NAVY-SH DLA-GS
USER: AIRFORCE 82
PROJECT NUMBER: 5320-0770

MILITARY SPECIFICATION SHEET

TITLE RIVET, BLIND, STRUCTURAL PULL STEM, SELF-PLUGGING, 100° FLUSH HEAD, TYPE II

SPECIFICATION SHEET NUMBER MS20601 10 AUG 92 REV J
SUPERSEDING MS20601 REV H 11 DEC 89
AMSC — N/A FSC 5320

Source: https://assist.dla.mil - Downloaded: 2026-10-22T14:23:25Z
Check the source to verify that this is the current version before use.

(J) TABLE VI. INTERCHANGEABILITY

INACTIVE PART NUMBERS		SUBSTITUTE PART NUMBERS	
MS20605			
MS20605	AD3E	MS20601	
	AD4E		AD4W
	AD5E		AD5W
	AD6E		AD6W
	AD8E		AD8W
	B3E		
	B4E		B4W
	B5E		B5W
	B6E		B6W
	B8E		B7W
	ML3E		----
	MP3E		----
	M3E		----
	ML4E		MP4W
	MP4E		MP4W
	M4E		M4W
	ML5E		MP5W
	MP5E		MP5W
	M5E		M5W
	ML6E		MP6W
	MP6E		MP6W
	M6E		M6W
	ML8E		MP8W
	MP8E		MP8W
MS20605	M8E	MS20601	M8W

CORRESPONDING GRIP NUMBERS ARE DIRECTLY INTERCHANGEABLE.

Source: https://assist.dla.mil -- Downloaded: 2025-10-23T16:22:32
Check the source to verify that this is the current version before use.