
THE REQUIREMENTS FOR ACQUIRING THE PRODUCT(S) DESCRIBED HEREIN SHALL CONSIST OF THIS SPECIFICATION SHEET AND THE ISSUE OF THE FOLLOWING SPECIFICATION LISTED IN THAT ISSUE OF THE DODISS SPECIFIED IN THE SOLICITATION: MIL-C-24788

THIS SPECIFICATION IS APPROVED FOR USE BY ALL DEPARTMENTS AND AGENCIES OF THE DEPARTMENT OF DEFENSE.


FORM APPROVED
OMB NO. 0704-0188

INCH-POUND

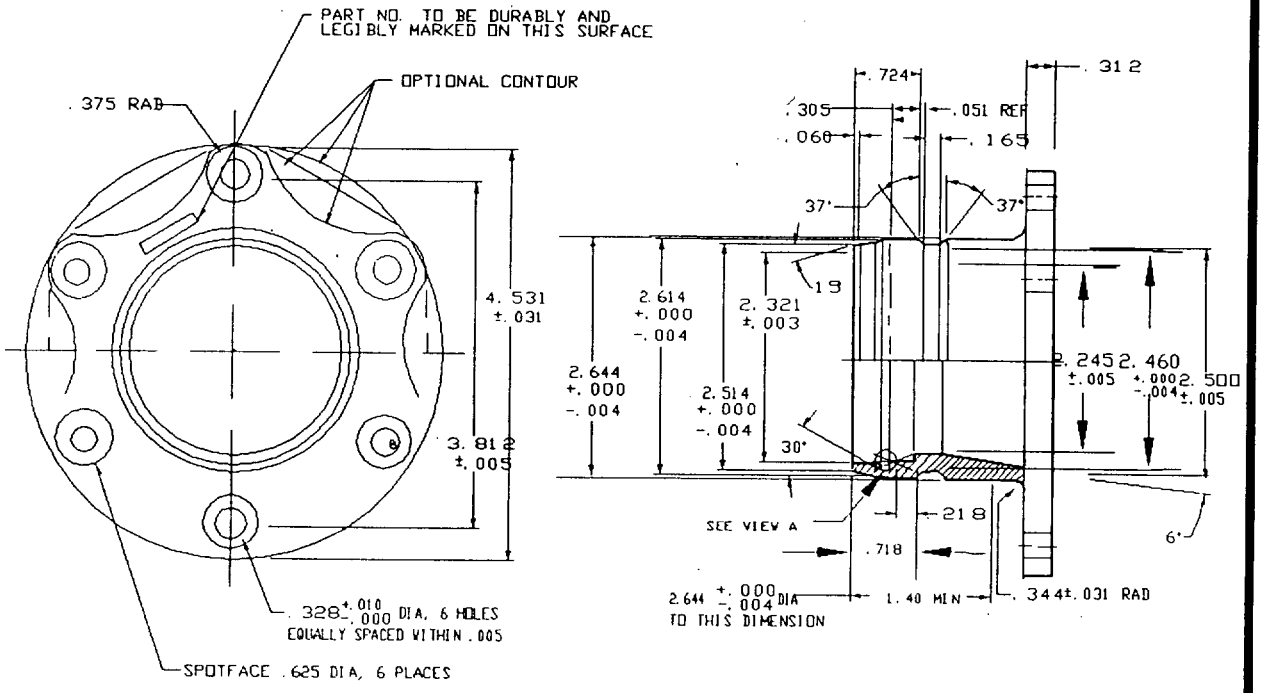

MS PART NO.	MATERIAL
MS26549 -1	AL ALLOY
~~MS26549 -2~~	~~BRONZE~~

Ⓐ

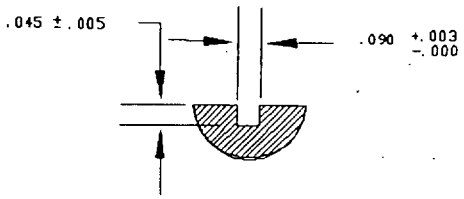

VIEW A
ENLARGED

Ⓐ NOTES:

1. ALL MACHINED SURFACES SHALL BE SMOOTH TO 63 MICROINCHES Ra MAXIMUM IN ACCORDANCE WITH ANSI B46.1
2. DIMENSIONS IN INCHES. UNLESS OTHERWISE SPECIFIED, TOLERANCES: DECIMALS: .010, ANGLES° 0.5.
3. THIS STANDARD TAKES PRECIDENCE OVER DOCUMENTS REFERENCED HEREIN.
4. REFERENCED DOCUMENTS SHALL BE OF THE ISSUE IN EFFECT ON DATE OF INVITATIONS FOR BID.
5. THIS DOCUMENT HAS BEEN PROMULGATED BY THE DEPARTMENT OF DEFENSE AS THE MILITARY STANDARD TO LIMIT THE SELECTION OF THE ITEM, PRODUCT, OR DESIGN COVERED HEREIN IN ENGINEERING, DESIGN, AND PROCUREMENT. THIS STANDARD SHALL BECOME EFFECTIVE NOT LATER THAN 90 DAYS AFTER THE LATEST DATE OF APPROVAL SHOWN.

PREPARING ACTIVITY: NAVY-AS
CUSTODIAN: NAVY - AS
AIR FORCE- DLA-
REVIEW ACTIVITY: NAVY - SH DLA - CS
NAVY - OS
PROJECT NUMBER: 4730-N113

MILITARY SPECIFICATION SHEET

TITLE

NIPPLE, QUICK DISCONNECT, 2-1/2 INCH, PRESSURE FUEL SERVICING, FLANGE TYPE

SPECIFICATION SHEET NUMBER: MS26549 — 8 AUG 1995 — REV: A

SUPERSEDING: MS26549 (AER) DATE: 17 MARCH 1958

AMSC-N/A FSC 4730

DISTRIBUTION STATEMENT
A. APPROVED FOR PUBLIC RELEASE; DISTRIBUTION IS UNLIMITED.

PAGE 1 OF 1

DD FORM 1 MAY 88 672 PREVIOUS EDITIONS OF THIS FORM ARE OBSOLETE

Source: https://assist.dla.mil -- Downloaded: 2026-10-23T15:12Z
Check the source to verify that this is the current version before use.