
THE REQUIRE... FOR ACQUIRING THE PRODUCT(S) DESCRIBED HEREIN SHALL CONSIST OF THIS SPECIFICAT
SHEET AND I... UE OF THE FOLLOWING SPECIFICATION LISTED IN THAT ISSUE OF THE DODISS SPECIFIED
THE SOLICITA... MIL-F-18280

FORM APPROVED
OMB NO. 0704-0188

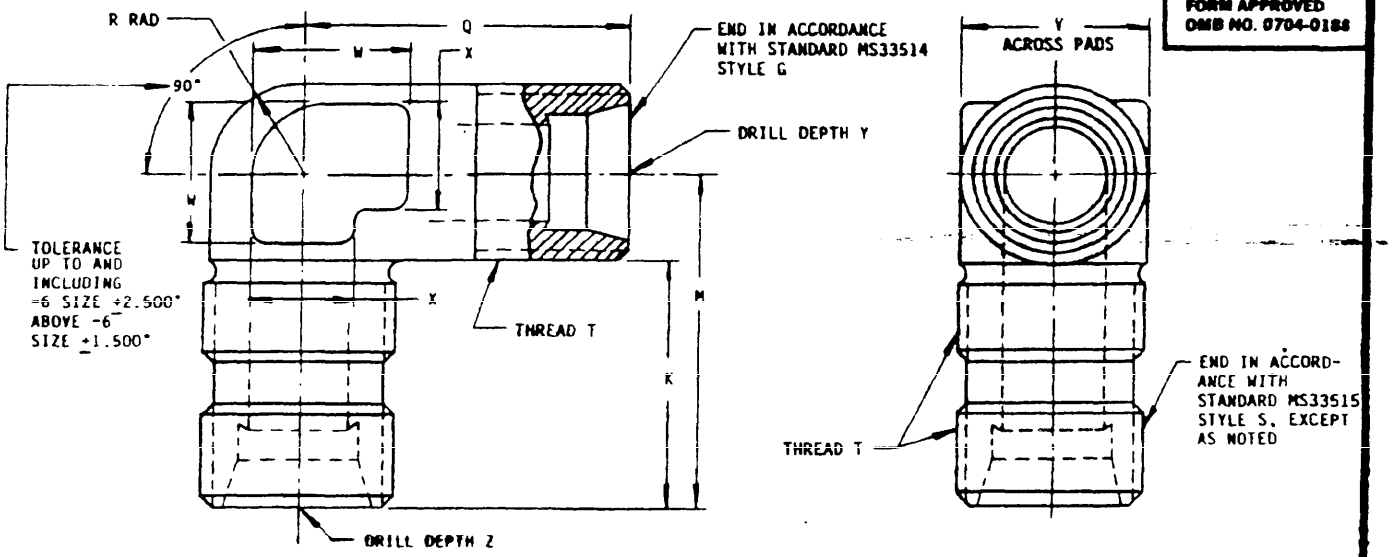

DASH NO.	TUBE OD	T THREAD MIL-S-8879	K MIN	M +.047 -.000	Q +.047 -.000	R	V	W APPROX	X APPROX	Y +.047 -.000	Z +.047 -.000	WEIGHT (LB MAX) STEEL	ALUM ALLOY	TI ALLOY
4	.250	.4375-20 UNJF-3A	.810	1.070	.940	.218	.437	.375	.250	.969	1.100	.065	.023	.037
5	.313	.5000-20 UNJF-3A		1.100	1.030	.250	.500	.500	.312	1.062	1.130	.071	.026	.040
6	.375	.5625-18 UNJF-3A	.850	1.180	1.060	.281	.562			1.094	1.210	.087	.032	.050
8	.500	.7500-16 UNJF-3A	1.010	1.440	1.310	.375	.750	.625	.438	1.344	1.470	.240	.075	.117
10	.625	.8750-14 UNJF-3A	1.140	1.650	1.500	.437	.875	.750		1.562	1.740	.297	.109	.171
12	.750	1.0625-12 UNJ -3A	1.250	1.870	1.620	.531	1.060	.875	.500	1.719	1.980	.469	.172	.270
16	1.000	1.3125-12 UNJ -3A		2.000	1.720	.656	1.310	1.062	.625	1.812	2.100	.625	.229	.360
20	1.250	1.6250-12 UNJ -3A		2.150	2.000	.812	1.620	1.250	.750	2.125	2.280	1.142	.419	.658

Ⓒ Ⓒ

REQUIREMENTS:

1. ~~MATERIAL:~~ ~~CARBON STEEL - FORGINGS~~
   ALUMINUM ALLOY - FORGINGS
   CORROSION RESISTANT STEEL - FORGINGS
   TITANIUM ALLOY - FORGINGS
   } SEE PROCUREMENT SPECIFICATION MIL-F-18280.

2. FINISH: SEE PROCUREMENT SPECIFICATION.

Ⓒ DENOTES CHANGE

INCH-POUND

FOR USE BY ALL DEPARTMENTS AND AGENCIES OF THE DEPARTMENT OF DEFENSE.
THIS SPECIFICATION IS AP...

PREPARING ACTIVITY: NAVY — AS
CUSTODIANS: ARMY — AV NAVY — AS
AIR FORCE — 99 DLA —
REVIEW: ARMY-AR, MI; AF-82;DLA-CS
USER: NAVY-OS; ARMY-GL, CR, ME, AT
MARINE CORP-MC
PROJECT NUMBER: 4730-0168

MILITARY SPECIFICATION SHEET

TITLE
ELBOW, 90° UNIVERSAL, FLARELESS TUBE, LOW PROFILE

SPECIFICATION SHEET NUMBER MS21926 REV C 3 JUL 92
SUPERSEDING MS21926 REV B 26 JUN 81
AMSC — N/A FSC 4730

Source: https://assist.dla.mil -- Downloaded: 2026-10-23T14:41Z
Check the source to verify that this is the current version before use.

DISTRIBUTION STATEMENT
A. APPROVED FOR PUBLIC RELEASE: DISTRIBUTION IS UNLIMITED.

FORM APPROVED
OMB NO. 0704-0188

(C) NOTES:

1. BREAK ALL SHARP EDGES AND REMOVE ALL BURRS AND SLIVERS.

2. DIMENSIONS ARE IN INCHES. UNLESS OTHERWISE SPECIFIED, TOLERANCES: DECIMALS: ±.016.

3. PART NUMBERS:

NO CODE LETTER IN PART NUMBER FOR CARBON STEEL
ADD "D" IN PLACE OF DASH FOR ALUMINUM ALLOY (2014).
ADD "W" IN PLACE OF DASH FOR ALUMINUM ALLOY (7075).
ADD "J" IN PLACE OF DASH FOR CORROSION-RESISTANT STEEL, TYPE 304.
ADD "K" IN PLACE OF DASH FOR CORROSION-RESISTANT STEEL, TYPE 316.
(C) ADD "R" AFTER DASH NUMBER FOR CORROSION-RESISTANT STEEL, TYPE 321.
ADD "T" AFTER DASH NUMBER FOR TITANIUM ALLOY (6AL-4V).
EXAMPLES OF PART NUMBERS:
MS21926-8 - ELBOW, 1/2 TUBING, CARBON STEEL.
MS21926D8 - ELBOW, 1/2 TUBING, ALUMINUM ALLOY (2014).
MS21926W8 - ELBOW, 1/2 TUBING, ALUMINUM ALLOY (7075).
MS21926J8 - ELBOW, 1/2 TUBING, CORROSION-RESISTANT STEEL, TYPE 304.
MS21926K8 - ELBOW, 1/2 TUBING, CORROSION-RESISTANT STEEL, TYPE 316.
(C) MS21926-8R- ELBOW, 1/2 TUBING, CORROSION-RESISTANT STEEL, TYPE 321.
MS21926-8T- ELBOW, 1/2 TUBING, TITANIUM ALLOY (6AL-4V).

(C) 4. ITEMS CODED "C" ON PREVIOUS ISSUES OF THIS STANDARD ARE NO LONGER TO BE FURNISHED. UNLESS OTHERWISE SPECIFIED, PARTS CODED "J", "K", OR "R" (AT SUPPLIER'S OPTION) SHALL BE FURNISHED IN LIEU OF "C" CODED PARTS.

5. TITANIUM NOT RECOMMENDED FOR USE IN OXYGEN SYSTEMS.

(C) 6. PARTS ARE NOT TO BE MANUFACTURED FROM TYPE 347 CRES AFTER TWO YEARS FROM THE DATE OF REVISON C OF THIS DOCUMENT. HOWEVER, TYPE CODE "S" PARTS MAY BE USED UNTIL EXISTING STOCK IS DEPLETED.

(C) 7. IN THE EVENT OF A CONFLICT BETWEEN THE TEXT OF THIS STANDARD AND THE REFERENCES CITED HEREIN, THE TEXT OF THIS STANDARD SHALL TAKE PRECEDENCE.

(C) 8. REFERENCED GOVERNMENT (OR NON-GOVERNMENT) DOCUMENTS OF THE ISSUE LISTED IN THAT ISSUE OF THE DEPARTMENT OF DEFENSE INDEX OF SPECIFICATIONS AND STANDARDS (DODISS) SPECIFIED IN THE SOLICITATION FORM A PART OF THIS STANDARD TO THE EXTENT SPECIFIED HEREIN.

(C) DENOTES CHANGE

PREPARING ACTIVITY: NAVY — AS
CUSTODIANS: ARMY — AV NAVY — AS
AIR FORCE — 99 DLA —
REVIEW: ARMY-AR, MI; AF-82;DLA-CS
USER: NAVY-OS; ARMY-GL, CR, ME, AT
MARINE CORP-MC
PROJECT NUMBER: 4730-0168

MILITARY SPECIFICATION SHEET

TITLE
ELBOW, 90° UNIVERSAL, FLARELESS TUBE, LOW PROFILE

SPECIFICATION SHEET NUMBER MS21926 REV C 3 JUL 92
SUPERSEDING MS21926 REV B 26 JUN 81
AMSC — N/A FSC 4730

Source: https://assist.dla.mil — Downloaded: 2026-10-23T14:41Z
Check the source to verify that this is the current version before use.

DISTRIBUTION STATEMENT
A APPROVED FOR PUBLIC RELEASE: DISTRIBUTION IS UNLIMITED.