

FED. SUP CLASS
6620

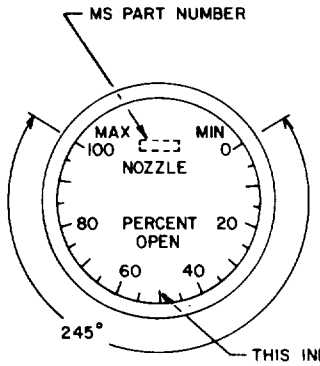

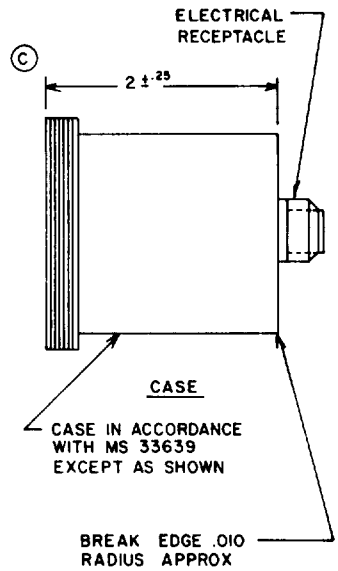

CAL MARKS	SETTING (DEG)	CONTINUED CAL MARKS	CONTINUED SETTING (DEG)
0	0		
–	12.25	–	134.75
——	24.50	60	147.0
–	36.75	-	159.75
20	49.0	——	171.50
–	61.25	–	183.75
——	73.50	80	196.0
–	85.75	–	208.25
40	98.0	——	220.50
–	110.25	–	232.75
——	122.50	100	245.0

	MS PART NO.	INTEGRAL LIGHT
✕	MS 24572-1	RED
✕	MS 24572-2	WHITE
©	~~MS 24572-3~~	~~RED~~
	MS 24572-4	WHITE

© ✕ CANCELLED, SUPERSEDED BY ~~MS 24572-3 AND~~ MS 24572-4. ~~MS 24572-3~~ AND MS 24572-4 PARTS CAN REPLACE THE CANCELLED MS 24572-1 AND MS 24572-2 RESPECTIVELY. THE CANCELLED MS 24572-1 AND MS 24572-2 PARTS CANNOT ALWAYS REPLACE THE ~~MS 24572-3~~ AND MS 24572-4 PARTS AND SHOULD BE USED UNTIL EXISTING STOCK IS DEPLETED. USE ONLY THE SUPERSEDING MS PARTS OF THE SAME DASH NUMBERS FOR DESIGN AND REPLACEMENT.

DIMENSIONS IN INCHES.

FOR DESIGN FEATURE PURPOSES, THIS STANDARD TAKES PRECEDENCE OVER PROCUREMENT DOCUMENTS REFERENCED HEREIN.

REFERENCED DOCUMENTS SHALL BE OF THE ISSUE IN EFFECT ON DATE OF INVITATIONS FOR BID.

APPROVED 27 MAY 1959 REVISED Ⓐ 6 JULY 1960 Ⓑ 25 APR 1961 © 30 September 1988

P.A. © AIR FORCE - 71 © Other Cust AIR FORCE - 99	INTERNATIONAL INTEREST •	TITLE INDICATOR - POSITION VARIABLE NOZZLE	MILITARY STANDARD MS 24572 (USAF)
PROCUREMENT SPECIFICATION MIL-I-27191	SUPERSEDES:		SHEET 1 OF 1

DD FORM 672-1 (LIMITED COORDINATION) PREVIOUS EDITIONS OF THIS FORM ARE OBSOLETE. 6620-F439

DISTRIBUTION STATEMENT A. Approved for public release; distribution is unlimited.
AMSC N/A

This military standard is approved for use within the Department of the Air Force, and is available for use by all Departments and Agencies of the Department of Defense.

DATE
DRAWN BY
TYPED BY
CHECKED BY

NOTES TO PRINTER: REDUCE BORDER TO 6 - 27 32 X 9 - 3 4. PRINT LEFT BORDER LINE ONE INCH FROM LEFT EDGE OF 8 X 10 - 1 2 SHEET. PRINT BOTTOM BORDER LINE 3/8 INCH FROM BOTTOM EDGE OF 8 X 10 - 1 2 SHEET. SIGNATURE FORM NOT TO BE INCLUDED ON 8 X 10 - 1 2 SHEET.

Source: https://assist.dla.mil -- Downloaded: 2026-10-23T14:16:12
Check the source to verify that this is the current version before use.