THE REQUIREMENTS FOR ACQUIRING THE PRODUCT(S) DESCRIBED HEREIN SHALL CONSIST OF THIS SPECIFICATION SHEET AND THE ISSUE OF THE FOLLOWING SPECIFICATION LISTED IN THAT ISSUE OF THE DODISS SPECIFIED IN THE SOLICITATION: MIL-F-8975

THIS SPECIFICATION IS APPROVED FOR USE BY ALL DEPARTMENTS AND AGENCIES OF THE DEPARTMENT OF DEFENSE

Form Approved
OMB No 0704-0188

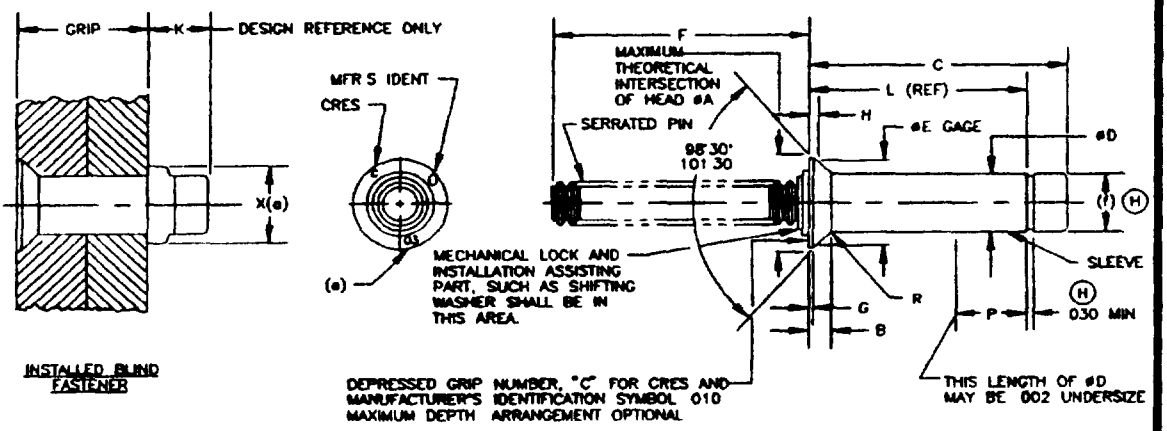


TABLE I FASTENER DIMENSIONS AND STRENGTHS.

SIZE DASH NUMBER (b)			NOM SIZE	øA	B	øD	øE	F	G	H	K		P	R	X	INSTALLED FASTENER		(H)
DOUBLE ACTION	SINGLE ACTION															MIN ULTIMATE SINGLE SHEAR (LBS)	MIN ULTIMATE TENSILE (LBS)	HOLE LIMITS (REF)
(c)	(c)	(d)			MAX		GAGE	MIN	MAX	GAGE	MAX	MIN	MAX	RAD MAX	(a) MIN			
~~-05~~	S05	U05	5/32	334	074	164 162	2832 2830	.844	011	.0206 0171	202	.120	215	010	195	1980	1150	167 164
~~-06~~	S06	U06	3/16	387	.082	199 197	3272 3270	875	013	0243 0205	.231	146	250	015	238	2925	1690	202 199
-	-08	U08	1/4	508	108	260 258	4320 4318	1 000	017	.0310 0270	279	188	305	020	315	5000	2900	263 260
-	-10	U10	5/16	635	140	312 310	5451 5449	1 218	020	0367 0325	319	224	350	.025	373	7200	4170	315 312
-	-12	U12	3/8	763	168	374 372	6582 6580	1 562	023	0428 0380	364	264	405	030	448	10380	5970	377 374

(a) MAXIMUM DIAMETER OF BLIND HEAD (X) SHALL NOT EXCEED MAXIMUM DIAMETER OF MANUFACTURED HEAD (A)

(b) SIZES "05" AND "06" WITH "-" ARE INSTALLED WITH A DOUBLE ACTION TOOL. ALL OTHER SIZES ARE INSTALLED WITH A SINGLE ACTION TOOL. SIZES "U05" AND "U06" MAY BE INSTALLED WITH A DOUBLE OR SINGLE ACTION TOOL. SEE AMENDMENT 2 OF MIL-F-8975 FOR TOOL SELECTION CHART

(H) (c) -05, -06 ~~S05, S06, -08, -10, AND -12~~ ARE INACTIVE FOR NEW DESIGN AFTER 1 JAN 91. USE U05, U06, S05 AND S06

(d) LETTER "U" SIGNIFIES SINGLE ACTION FASTENER WITHOUT FRANGIBLE TYPE OF LOCKING COLLAR OR LOCKING COLLAR CAP. "U" AND "S" CODE FASTENERS IN SIZES "05" AND "06" ARE COLOR IDENTIFIED GREEN ON LOCKING COLLAR, SHIFTING WASHER OR SERRATED PIN. "S" CODE FASTENERS MAY BE SUPPLIED WITH A LOCKING COLLAR CAP

(e) SINGLE DIGIT MARKING IS PERMISSIBLE FOR GRIP DASH NUMBERS LESS THAN 10

(H) (f) DIAMETER OF SERRATED PIN HEAD SHALL NOT EXCEED "øD" MAX AND MAY BE 002 BELOW "øD" MIN IN AREA "F" ONLY

(H) DENOTES CHANGE(S)

INCH - POUND

PREPARING ACTIVITY: DLA - IS
CUSTODIANS: ARMY - AV; NAVY - AS; AIR FORCE - 99; DLA -
REVIEW: MI, 82
USER
PROJECT NUMBER: 5320-0807

MILITARY SPECIFICATION SHEET

TITLE: FASTENER, BLIND, HIGH STRENGTH, PULL TYPE, POSITIVE MECHANICAL LOCK, 100° FLUSH HEAD, CORROSION RESISTING STEEL, 95 KSI Fsu

SPECIFICATION SHEET NUMBER
MS21140 — 31 MAR 1994, REV H

SUPERSEDING
MS21140 G — 24 DEC 90

AMSC - N/A — FSC 5320

DISTRIBUTION STATEMENT
A. Approved for public release; distribution is unlimited

DD Form 672, MAY 88 — PREVIOUS EDITIONS ARE OBSOLETE

Source: https://assist.dla.mil -- Downloaded: 2026-10-23T14:27Z
Check the source to verify that this is the current version before use.

THIS SPECIFICATION IS APPROVED FOR USE BY ALL DEPARTMENTS AND AGENCIES OF THE DEPARTMENT OF DEFENSE

THE REQUIREMENTS FOR ACQUIRING THE PRODUCT(S) DESCRIBED HEREIN SHALL CONSIST OF THIS SPECIFICATION SHEET AND THE ISSUE OF THE FOLLOWING SPECIFICATION LISTED IN THAT ISSUE OF THE DODSS SPECIFIED IN THE SOLICITATION MIL-F-8975

Form Approved
OMB No 0704-0188

TABLE I GRIP TABULATIONS

#5/32 (-05)				#3/16 (-06)				#1/4 (-08)				#5/16 (-10)				#3/8 (-12)			
GRIP DASH NO	GRIP RANGE MIN	GRIP RANGE MAX	C MAX	GRIP DASH NO	GRIP RANGE MIN	GRIP RANGE MAX	C MAX	GRIP DASH NO	GRIP RANGE MIN	GRIP RANGE MAX	C MAX	GRIP DASH NO	GRIP RANGE MIN	GRIP RANGE MAX	C MAX	GRIP DASH NO	GRIP RANGE MIN	GRIP RANGE MAX	C MAX
-0502	094	157	434	-0602	120	157	505	-0803	156	220	616	-1004	219	282	743	-1204	219	282	820
-0503	156	220	498	-0603	156	220	541	-0804	219	282	678	-1005	281	345	805	-1205	281	345	883
-0504	219	282	559	-0604	219	282	604	-0805	281	345	740	-1006	344	407	868	-1206	344	407	945
-0505	281	345	622	-0605	281	345	666	-0806	344	407	803	-1007	405	470	930	-1207	406	470	1 007
-0506	344	407	684	-0606	344	407	729	-0807	406	470	866	-1008	469	532	993	-1208	469	532	1 070
-0507	406	470	746	-0607	406	470	791	-0808	469	532	928	-1009	531	595	1 055	-1209	531	595	1 133
-0508	469	532	809	-0608	469	532	854	-0809	531	595	990	-1010	594	657	1 118	-1210	594	657	1 195
-0509	531	595	872	-0609	531	595	916	-0810	594	657	1 053	-1011	656	720	1 180	-1211	656	720	1 257
-0510	594	657	934	-0610	594	657	979	-0811	656	720	1 116	-1012	719	782	1 243	-1212	719	782	1 320
-0511	656	720	996	-0611	656	720	1 041	-0812	719	782	1 178	-1013	781	845	1 305	-1213	781	845	1 383
-0512	719	782	1 059	-0612	719	782	1 104	-0813	781	845	1 240	-1014	844	907	1 368	-1214	844	907	1 445
-0513	781	845	1 122	-0613	781	845	1 166	-0814	844	907	1 303	-1015	906	970	1 430	-1215	906	970	1 507
-0514	844	907	1 184	-0614	844	907	1 229	-0815	906	970	1 366	-1016	969	1 032	1 493	-1216	969	1 032	1 570
-0515	906	970	1 246	-0615	906	970	1 291	-0816	969	1 032	1 428	-1017	1 031	1 095	1 555	-1217	1 031	1 095	1 633
-0516	969	1 032	1 309	-0616	969	1 032	1 354	-0817	1 031	1 095	1 416	-1018	1 094	1 157	1 618	-1218	1 094	1 157	1 695
				-0617	1 031	1 095	1 416	-0818	1 094	1 157	1 479	-1019	1 156	1 220	1 680	-1219	1 155	1 220	1 757
				-0618	1 094	1 157	1 479	-0819	1 156	1 220	1 541	-1020	1 219	1 282	1 743	-1220	1 219	1 282	1 820
				-0619	1 156	1 220	1 541	-0820	1 219	1 282	1 604	-1021	1 281	1 345	1 805	-1221	1 281	1 345	1 883
				-0620	1 219	1 282	1 604	-0821	1 281	1 345	1 866	-1022	1 344	1 407	1 868	-1222	1 344	1 407	1 945
				-0621	1 281	1 345	1 866	-0822	1 344	1 407	1 729	-1023	1 406	1 470	1 930	-1223	1 406	1 470	2 007
				-0622	1 344	1 407	1 729	-0823	1 406	1 470	1 791	-1024	1 469	1 532	1 993	-1224	1 469	1 532	2 070
				-0623	1 406	1 470	1 791	-0824	1 469	1 532	1 854	-1025	1 531	1 595	2 055	-1225	1 531	1 595	2 133
				-0624	1 469	1 532	1 854	-0825	1 531	1 595	1 916	-1026	1 594	1 657	2 118	-1226	1 594	1 657	2 195
				-0625	1 531	1 595	1 916	-0826	1 594	1 657	1 979	-1027	1 656	1 720	2 180	-1227	1 656	1 720	2 257
				-0626	1 594	1 657	1 979					-1028	1 719	1 782	2 243	-1228	1 719	1 782	2 320
																-1229	1 781	1 845	2 383
																-1230	1 844	1 907	2 445
																-1231	1 906	1 970	2 507
																-1232	1 969	2 032	2 570

GRIP DASH NO	L	GRIP DASH NO	L	GRIP DASH NO	L	GRIP DASH NO	L	GRIP DASH NO	L	GRIP DASH NO	L
-0502	280	-0602	329	-0803	406	-1004	506	-1204	548		
-0503	342	-0603	365	-0804	469	-1005	568	-1205	610		
-0504	405	-0604	428	-0805	531	-1006	631	-1206	673		
-0505	467	-0605	490	-0806	594	-1007	693	-1207	735		
-0506	530	-0606	553	-0807	656	-1008	756	-1208	798		
-0507	592	-0607	615	-0808	719	-1009	818	-1209	860		
-0508	655	-0608	678	-0809	781	-1010	881	-1210	923		
-0509	717	-0609	740	-0810	844	-1011	943	-1211	985		
-0510	780	-0610	803	-0811	908	-1012	969	-1212	1 048		
-0511	842	-0611	865	-0812	969	-1013	1 031	-1213	1 110		
-0512	905	-0612	928	-0813	1 031	-1014	1 094	-1214	1 173		
-0513	967	-0613	990	-0814	1 094	-1015	1 156	-1215	1 235		
-0514	1 030	-0614	1 053	-0815	1 156	-1016	1 219	-1216	1 298		
-0515	1 092	-0615	1 115	-0816	1 219	-1017	1 281	-1217	1 360		
-0516	1 155	-0616	1 178	-0817	1 281	-1018	1 344	-1218	1 423		
		-0617	1 240	-0818	1 344	-1019	1 406	-1219	1 485		
		-0618	1 303	-0819	1 406	-1020	1 469	-1220	1 548		
		-0619	1 365	-0820	1 469	-1021	1 531	-1221	1 610		
		-0620	1 428	-0821	1 531	-1022	1 594	-1222	1 673		
		-0621	1 490	-0822	1 594	-1023	1 656	-1223	1 735		
		-0622	1 553	-0823	1 656	-1024	1 719	-1224	1 798		
		-0623	1 615	-0824	1 719	-1025	1 781	-1225	1 860		
		-0624	1 678	-0825	1 781	-1026	1 844	-1226	1 923		
		-0625	1 740	-0826	1 844	-1027	1 906	-1227	1 985		
		-0626	1 803			-1028	1 969	-1228	2 048		
								-1229	2 110		
								-1230	2 173		
								-1231	2 235		
								-1232	2 298		

PREPARING ACTIVITY DLA - IS

CUSTODIANS ARMY-AV NAVY-AS
AIR FORCE-99 DLA-

REVIEW MI, 82
USER

PROJECT NUMBER 5320-0807

MILITARY SPECIFICATION SHEET

TITLE
FASTENER, BLIND, HIGH STRENGTH, PULL TYPE, POSITIVE MECHANICAL LOCK, 100° FLUSH HEAD, CORROSION RESISTING STEEL, 95 KSI Fsu

SPECIFICATION SHEET NUMBER
MS21140 31 MAR 1994 REV H

SUPERSEDING
MS21140 G 24 DEC 90

AMSC- N/A FSC 5320

DISTRIBUTION STATEMENT
A. Approved for public release distribution is unlimited

DD Form 672, MAY 88 PREVIOUS EDITIONS ARE OBSOLETE

Source: https://assist.dla.mil -- Downloaded: 2026-10-23T14:27Z
Check the source to verify that this is the current version before use.

THE REQUIREMENTS FOR ACQUIRING THE PRODUCT(S) DESCRIBED HEREIN SHALL CONSIST OF THIS SPECIFICATION SHEET AND THE ISSUE OF THE FOLLOWING SPECIFICATION LISTED IN THAT ISSUE OF THE DODISS SPECIFIED IN THE SOLICITATION MIL-F-8975

THIS SPECIFICATION IS APPROVED FOR USE BY ALL DEPARTMENTS AND AGENCIES OF THE DEPARTMENT OF DEFENSE

Form Approved
OMB No 0704-0188

REQUIREMENTS

1 MATERIAL

SLEEVE	CORROSION RESISTING STEEL PER CHEMICAL REQUIREMENTS OF AMS5737 (A286)
SERRATED PIN	CORROSION RESISTING STEEL PER CHEMICAL REQUIREMENTS OF AMS5737 (A286)
MECHANICAL LOCK	CORROSION RESISTING STEEL PER CHEMICAL REQUIREMENTS OF AMS5737 OR TYPE 316 CRES CONFORMING TO THE CHEMICAL REQUIREMENTS OF AMS5690

2 PROTECTIVE TREATMENT

SLEEVE	PASSIVATION PER QQ-P-35, OR CADMIUM PLATED PER QQ-P-416 TYPE II, (CLEAR DICHROMATE), CLASS 2
SERRATED PIN	PASSIVATION PER QQ-P-35
MECHANICAL LOCK	PASSIVATION PER QQ-P-35

3 LUBRICATION. WHEN LUBRICATED, PARTS SHALL BE LUBRICATED PER MIL-L-46010 TYPE I OR MIL-L-87132

4 HOLE PREPARATION. SEE MS33522 EXCEPT FOR HOLE SIZE SHOWN IN MIL-F-8975

(H) 5 EXAMPLE OF PART NUMBER. (FOR INACTIVE CODES SEE SHEET 1 FOOTNOTE (c))

MS21140 - 0803P = 1/4 DIA. NOM SIZE, .156 MIN GRIP, CADMIUM PLATED, INSTALLED WITH A SINGLE ACTION TOOL

- "P" DENOTES CADMIUM PLATING
- NO CODE DENOTES PASSIVATION TREATMENT
- GRIP RANGE (SEE TABLE II)
- SIZE DASH NUMBER (SEE TABLE I)
- \- DENOTES FASTENERS INSTALLED WITH A DOUBLE ACTION TOOL FOR SIZES 05 AND 06
- '- DENOTES FASTENERS INSTALLED WITH A SINGLE ACTION TOOL FOR SIZES 08, 10, AND 12
- 'S' DENOTES FASTENERS INSTALLED WITH A SINGLE ACTION TOOL FOR SIZES 05 AND 06
- 'U DENOTES SINGLE ACTION TOOL FASTENERS INSTALLED WITH A SINGLE ACTION TOOL FOR ALL SIZES (SEE SHEET 1, FOOTNOTE(d))
- MS NUMBER

NOTES.

1 DIMENSIONS ARE IN INCHES UNLESS OTHERWISE SPECIFIED TOLERANCES DECIMALS ± .010

(H) 2 IN THE EVENT OF A CONFLICT BETWEEN THE TEXT OF THIS DOCUMENT AND THE REFERENCES CITED HEREIN, THE TEXT OF THIS DOCUMENT SHALL TAKE PRECEDENCE

(H) 3 UNLESS OTHERWISE SPECIFIED ISSUES OF REFERENCED DOCUMENTS ARE THOSE IN EFFECT AT THE TIME OF SOLICITATION

PREPARING ACTIVITY DLA - IS CUSTODIANS ARMY-AV NAVY-AS AIR FORCE-99 DLA- REVIEW MI, 82 USER. PROJECT NUMBER 5320-0807	MILITARY SPECIFICATION SHEET TITLE FASTENER, BLIND, HIGH STRENGTH PULL TYPE, POSITIVE MECHANICAL LOCK, 100° FLUSH HEAD CORROSION RESISTING STEEL, 95 KSI Fsu	SPECIFICATION SHEET NUMBER MS21140 31 MAR 1994 REV H SUPERSEDING MS21140 G 24 DEC 90 AMSC- N/A FSC 5320
DISTRIBUTION STATEMENT A. Approved for public release distribution is unlimited		Page 1 of 3

DD Form 672, MAY 88 PREVIOUS EDITIONS ARE OBSOLETE

Source: https://assist.dla.mil -- Downloaded: 2026-10-23T14:27Z
Check the source to verify that this is the current version before use.