
FSC-1650

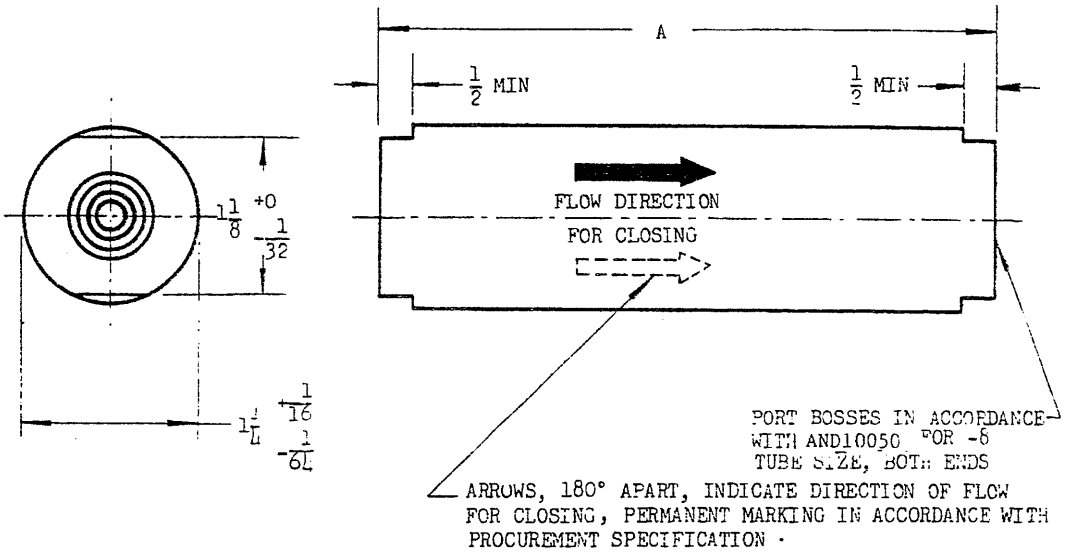

(a) FIRST DASH NO.	TUBE OD	A ±1/16	~~THREAD~~	RATED VOLUMETRIC CAPACITY CU IN.
~~(b) -4~~	~~1/4~~	~~4-13/16~~	~~7/16-20 NF-3~~	10, 20, 40, 60, 80, 120, 160, 200, 250
~~(b) -6~~	~~3/8~~	~~4-13/16~~	~~9/16-18 NF-3~~	
-8	1/2	5- 7/8	~~3/4-16 NF~~	

(a) SECOND DASH NUMBER INDICATES RATED CAPACITY IN CUBIC INCHES.

(b) PART NOS. AN6282-4 AND AN6282-6 INACTIVE FOR DESIGN AFTER 11 JULY 1951. USE AN6282-8 WITH ADAPTER.

(4) FOR DEFINTION AND APPLICATION OF DRAWING STATUS NOTES, SEE MIL-STD-962

EXAMPLE OF PART NO.: AN6282-8-20 = FUSE FOR 1/2 OD TUBE WITH RATED CAPACITY OF 20 CUBIC INCHES.

DIMENSIONS IN INCHES. UNLESS OTHERWISE SPECIFIED, TOLERANCES: FRACTIONS ±1/64.

THE AIRPLANE OR ENGINE MANUFACTURER SHALL ALLOW CLEARANCE FOR THE MAXIMUM DIMENSIONS SHOWN ON THIS DRAWING FOR INSTALLATION.

TYPE II FUSE WILL NOT RESET ITSELF WITHOUT REVERSE FLOW.

APPROVED 22 Jun 48 REVISED (1) 11 Jul 51 (2) 15 Dec 52 (3) 14 Apr 53 (4) 21 April 1981

PROCUREMENT SPECIFICATION	AIR FORCE-NAVY AERONAUTICAL STANDARD	AN6282
MIL-F-5508	FUSE - HYDRAULIC QUANTITY MEASURING CLASS 3000 TYPE II	

PROJ No.: 1650-3361

P.A.:
Air Force - 99
Cust: AF - 99
Navy -AS

NOTES TO PRINTER

DRAWN BY M.A.R. DATE 7-6-51

NOTICE.—When Government drawing, specifications, or other data are used for any purpose other than in connection with a definitely related Government procurement operation, the United States Government thereby incurs no responsibility, nor any obligation whatsoever; and the fact that the Government may have formulated, furnished, or in any way supplied the said drawings, specifications, or other data is not to be regarded by implication or otherwise as in any manner licensing the holder or any other person or corporation, or conveying any rights or permission to manufacture, use, or sell any patented invention that may in any way be related thereto.

NOTE.—This drawing was approved by joint action of the Air Force and Navy Department as the Air Force-Navy standard for this product. This drawing supersedes all antecedent standard drawings for the same product and shall become effective for procurement of commercial supplies, or for use in new design, not later than six months after the latest date of approval shown.

Source: https://assist.dla.mil -- Downloaded: 20260-26114:232
Check the source to verify that this is the current version before use.