THE REQUIREMENTS FOR ACQUIRING THE PRODUCT(S) DESCRIBED HEREIN SHALL CONSIST OF THIS SPECIFICATION SHEET AND THE ISSUE OF THE FOLLOWING SPECIFICATION LISTED IN THAT ISSUE OF THE DODISS SPECIFIED IN THE SOLICITATION MIL-R-7885

IS SPECIFICATION IS A ED FOR USE
ALL DEPARTMENTS AN ENCIES OF THE
PARTMENT OF DEFENSE

Form approved
OMB No 0704-0188

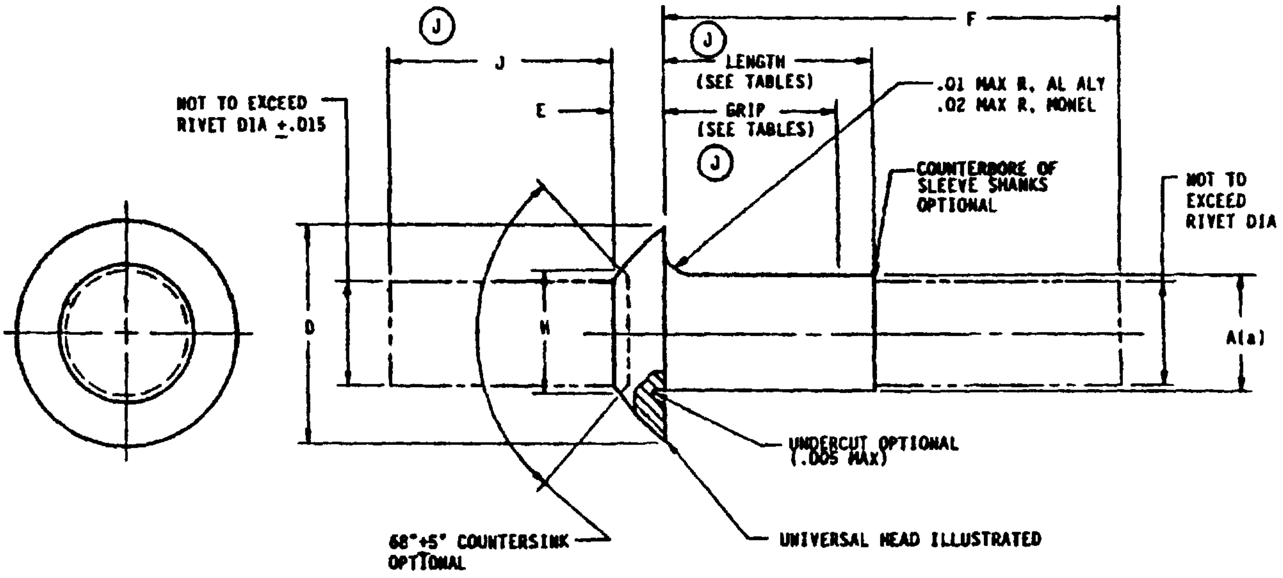
Ⓙ
J
E
NOT TO EXCEED RIVET DIA ±.015
F
Ⓙ LENGTH (SEE TABLES)
GRIP (SEE TABLES)
Ⓙ
.01 MAX R. AL ALY
.02 MAX R. MONEL
COUNTERBORE OF SLEEVE SHANKS OPTIONAL
NOT TO EXCEED RIVET DIA
D
H
A(a)
UNDERCUT OPTIONAL (.005 MAX)
68°±5° COUNTERSINK OPTIONAL
UNIVERSAL HEAD ILLUSTRATED

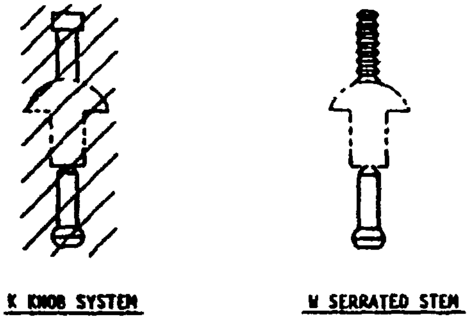
K KNOB SYSTEM

W SERRATED STEM

RIVET IDENTIFICATION CODE

Ⓙ TABLE I. DIMENSIONS.

RIVET SIZE NOM DIA	A (a) +.003 -.001 DIA	UNIVERSAL HEAD		H MAX DIA	J MIN
		D DIA	E +.010 -.000		
1/8	.125	.250 ± .012	.054	.110	0.750
5/32	.156	.312 ± .016	.067	.138	0.750
3/16	.187	.375 ± .019	.080	.161	0.750
1/4	.250	.500 ± .025	.107	.215	1.000

Ⓙ

(a) .001 SHANK DIA INCREASE PERMISSIBLE WITHIN .100 INCH OF BASE OF HEAD.

Ⓙ DENOTES CHANGES

PREPARING ACTIVITY NAVY-AS
CUSTODIANS ARMY- AR NAVY-
AIR FORCE-99 DLA-
REVIEW ARMY-ER, AV, MI NAVY-SH DLA-IS
AIR FORCE 82
PROJECT NUMBER 5320-0769

MILITARY SPECIFICATION SHEET

TITLE RIVET, BLIND, STRUCTURAL PULL STEM, SELF-PLUGGING, PROTRUDING HEAD, TYPE II

SPECIFICATION SHEET NUMBER
MS20600
10 AUG 92
REV J

SUPERSEDING
MS20600, REV H, 11 DEC 89

AMSC- N/A FSC 5320

Form approved
OMB No. 0704-0188

W-SERRATED STEM

Ⓙ TABLE II 1/8 RIVET DIAMETER (NOMINAL), PART NUMBERS AND DIMENSIONS

2117 AL	5056 AL	MONEL	MONEL, CADMIUM PLATED				
DASH NO.	DASH NO.	DASH NO.	DASH NO.	GRIP RANGE		LENGTH MAX	F MAX
				MIN	MAX		
AD4W1	B4W1	M4W1	MP4W1	UP TO .062		.170	.500
AD4W2	B4W2	M4W2	MP4W2	.063	.125	.232	.600
AD4W3	B4W3	M4W3	MP4W3	.126	.187	.295	.750
AD4W4	B4W4	M4W4	MP4W4	.188	.250	.357	.850
AD4W5	B4W5	M4W5	MP4W5	.251	.312	.420	1.010
AD4W6	B4W6	M4W6	MP4W6	.313	.375	.482	1.100
AD4W7	B4W7	M4W7	MP4W7	.376	.437	.545	1.197
AD4W8	B4W8	M4W8	MP4W8	.438	.500	.607	1.322
AD4W9	B4W9	M4W9	MP4W9	.501	.562	.670	1.509
AD4W10	B4W10	M4W10	MP4W10	.563	.625	.722	1.600
AD4W11	B4W11	M4W11	MP4W11	.626	.687	.785	1.720
AD4W12	B4W12	M4W12	MP4W12	.688	.750	.847	1.820

Ⓙ TABLE III 5/32 RIVET DIAMETER (NOMINAL), PART NUMBERS AND DIMENSIONS.

2117 AL	5056 AL	MONEL	MONEL, CADMIUM PLATED				
DASH NO.	DASH NO.	DASH NO.	DASH NO.	GRIP RANGE		LENGTH MAX	F MAX
				MIN	MAX		
AD5W1	B5W1	M5W1	MP5W1	UP TO .062		.192	.558
AD5W2	B5W2	M5W2	MP5W2	.063	.125	.254	.620
AD5W3	B5W3	M5W3	MP5W3	.126	.187	.317	.808
AD5W4	B5W4	M5W4	MP5W4	.188	.250	.379	.870
AD5W5	B5W5	M5W5	MP5W5	.251	.312	.441	1.058
AD5W6	B5W6	M5W6	MP5W6	.313	.375	.503	1.120
AD5W7	B5W7	M5W7	MP5W7	.376	.437	.567	1.339
AD5W8	B5W8	M5W8	MP5W8	.438	.500	.629	1.401
AD5W9	B5W9	M5W9	MP5W9	.501	.562	.692	1.567
AD5W10	B5W10	M5W10	MP5W10	.563	.625	.754	1.630
AD5W11	B5W11	M5W11	MP5W11	.626	.687	.817	1.817
AD5W12	B5W12	M5W12	MP5W12	.688	.750	.879	1.880
AD5W13	B5W13	M5W13	MP5W13	.751	.812	.942	2.067
AD5W14	B5W14	M5W14	MP5W14	.813	.875	1.004	2.130

Ⓙ TABLE IV. 3/16 RIVET DIAMETER (NOMINAL), PART NUMBERS AND DIMENSIONS

2117 AL	5056 AL	MONEL	MONEL, CADMIUM PLATED				
DASH NO.	DASH NO.	DASH NO.	DASH NO.	GRIP RANGE		LENGTH MAX	F MAX
				MIN	MAX		
AD6W1	B6W1	M6W1	MP6W1	UP TO .062		.215	.638
AD6W2	B6W2	M6W2	MP6W2	.063	.125	.277	.700
AD6W3	B6W3	M6W3	MP6W3	.126	.187	.340	.888
AD6W4	B6W4	M6W4	MP6W4	.188	.250	.402	.950
AD6W5	B6W5	M6W5	MP6W5	.251	.312	.465	1.138
AD6W6	B6W6	M6W6	MP6W6	.313	.375	.527	1.200
AD6W7	B6W7	M6W7	MP6W7	.376	.437	.590	1.419
AD6W8	B6W8	M6W8	MP6W8	.438	.500	.652	1.481
AD6W9	B6W9	M6W9	MP6W9	.501	.562	.715	1.637
AD6W10	B6W10	M6W10	MP6W10	.563	.625	.777	1.699
AD6W11	B6W11	M6W11	MP6W11	.626	.687	.840	1.887
AD6W12	B6W12	M6W12	MP6W12	.688	.750	.902	1.949
AD6W13	B6W13	M6W13	MP6W13	.751	.812	.965	2.074
AD6W14	B6W14	M6W14	MP6W14	.813	.875	1.027	2.199

Ⓙ TABLE V 1/4 RIVET DIAMETER (NOMINAL), PART NUMBERS AND DIMENSIONS

2117 AL	5056 AL	MONEL	MONEL, CADMIUM PLATED				
DASH NO.	DASH NO.	DASH NO.	DASH NO.	GRIP RANGE		LENGTH MAX	F MAX
				MIN	MAX		
AD8W3	B8W3	M8W3	MP8W3	.125	.187	.385	.970
AD8W4	B8W4	M8W4	MP8W4	.188	.250	.447	1.090
AD8W5	B8W5	M8W5	MP8W5	.251	.312	.510	1.220
AD8W6	B8W6	M8W6	MP8W6	.313	.375	.572	1.340
AD8W7	B8W7	M8W7	MP8W7	.376	.437	.635	1.470
AD8W8	B8W8	M8W8	MP8W8	.438	.500	.697	1.590
AD8W9	B8W9	M8W9	MP8W9	.501	.562	.760	1.720
AD8W10	B8W10	M8W10	MP8W10	.563	.625	.822	1.840
AD8W11	B8W11	M8W11	MP8W11	.626	.687	.885	1.970
AD8W12	B8W12	M8W12	MP8W12	.688	.750	.947	2.090
AD8W13	B8W13	M8W13	MP8W13	.751	.812	1.010	2.220
AD8W14	B8W14	M8W14	MP8W14	.813	.875	1.072	2.340
AD8W15	B8W15	M8W15	MP8W15	.876	.937	1.134	2.405
AD8W16	B8W16	M8W16	MP8W16	.938	1.000	1.196	2.530

PREPARING ACTIVITY NAVY-AS
CUSTODIANS ARMY-AR NAVY-
AIR FORCE-99 DLA-
REVIEW ARMY-ER, AV, MI NAVY-SH DLA-IS
AIR FORCE 82
PROJECT NUMBER 5320-0760

MILITARY SPECIFICATION SHEET
TITLE RIVET, BLIND, STRUCTURAL PULL STEM, SELF-PLUGGING, PROTRUDING HEAD, TYPE II

SPECIFICATION SHEET NUMBER
MS20600
10 AUG 92
REV J
SUPERSEDING
MS20600, REV H, 11 DEC 89

FORM APPROVED
OMB NO 0704-0188

Ⓙ REQUIREMENTS:

1. MATERIAL: SLEEVES; AL ALLOY, COMP 2117, QQ-A-430.
   AL ALLOY, COMP 5056, QQ-A-430.
   NICKEL-COPPER-ALLOY (MONEL), CLASS A, QQ-N-281.
   PINS; AL ALLOY, COMP 2017, QQ-A-430.
   AL ALLOY, COMP 5056, QQ-A-430.
   NICKEL-COPPER-ALLOY (MONEL), CLASS A, QQ-N-281.

2. FINISH: ALUMINUM ALLOY; ANODIZE IN ACCORDANCE WITH MIL-A-8625 OR CHEMICALLY SURFACE TREAT IN ACCORDANCE WITH MIL-C-5541.
   NICKEL-COPPER-ALLOY (MONEL); CADMIUM-PLATED IN ACCORDANCE WITH PROCUREMENT SPECIFICATION.
   ~~NO LETTER AFTER MATERIAL DESIGNATION INDICATES NO FINISH REQUIRED.~~

3. COLOR. 5056 ALUMINUM ALLOY RIVETS SHALL BE SUITABLY IDENTIFIED BY AN ORANGE COLOR IN ACCORDANCE WITH FEDERAL STANDARD NUMBER 596, COLOR NUMBER 32246.

4. ADD "AD" IN PLACE OF DASH TO INDICATE ALUMINUM ALLOY, COMPOSITION 2117.
   ADD "B" IN PLACE OF DASH TO INDICATE ALUMINUM ALLOY, COMPOSITION 5056.
   ADD "M" IN PLACE OF DASH TO INDICATE NICKEL-COPPER-ALLOY (MONEL).
   ~~ADD "ML" IN PLACE OF DASH TO INDICATE NICKEL COPPER ALLOY (MONEL) SILVER PLATED.~~
   ADD "P" AFTER MATERIAL DESIGNATION TO INDICATE CADMIUM PLATE.

5. ~~ADD IDENTIFICATION CODE LETTERS AFTER DASH NUMBER TO INDICATE TYPE OF RIVET BASED ON METHOD OF INSTALLATION.~~
   ~~ADD "K" TO INDICATE KNOB STEM RIVET.~~
   ~~ADD "W" TO INDICATE SERRATED STEM RIVET.~~
   ~~NO LETTER INDICATES A COMPLETE RIVET WITH TYPE OF STEM OPTIONAL. INACTIVE FOR DESIGN AFTER 21 MARCH 1962.~~
   ~~CANCELLED AFTER 1 FEBRUARY 1960.~~

Ⓙ NOTES:

1. EXAMPLES OF PART NUMBERS:
   MS20600 AD5W5 - RIVET, 2117 ALUMINUM ALLOY SLEEVE, .156 DIA, SERRATED STEM, .251 TO .312 GRIP RANGE.
   MS20600 B5W5 - RIVET, 5056 AL ALLOY SLEEVE, .156 DIA, SERRATED STEM, .251 TO .312 GRIP RANGE.
   MS20600 MP5W5 - RIVET, NICKEL-ALLOY (MONEL) SLEEVE, CADMIUM-PLATED, .156 DIA, SERRATED STEM, .251 TO .312 GRIP RANGE.

2. DIMENSIONS ARE IN INCHES, UNLESS OTHERWISE SPECIFIED.

Ⓙ 3. FOR QUALIFIED PRODUCTS, SEE QPL-7885.

4. FOR DESIGN USAGE LIMITATIONS, USE MS33522.

5. SILVER-PLATED NICKEL-COPPER-ALLOY (MONEL) (SERIES ML) RIVETS SHALL BE INACTIVE FOR DESIGN AFTER (DATE). USE EXISTING STOCK UNTIL DEPLETED. USE MONEL (SERIES M) OR CADMIUM-PLATED MONEL (SERIES MP) RIVETS IDENTIFIED BY THE SAME DASH NUMBER. KNOB STEM RIVETS (SERIES K) AND "NO LETTER RIVETS" INACTIVE FOR DESIGN AFTER 21 MARCH 1962, USE MS20600, SHEET 2, SERRATED STEM RIVETS (SERIES W). KNOB STEM RIVETS (SREIES K) WILL BE CANCELLED FROM THIS STANDARD 21 MARCH 1965.

6. INTERCHANGEABILITY RELATIONSHIP: SERRATED STEM RIVETS (SERIES W) ARE UNIVERSALLY, FUNCTIONALLY, AND DIMENSIONALLY INTERCHANGEABLE WITH KNOB STEM RIVETS (SERIES K) WITH PROPER TOOLING.

7. KNOB STEM RIVETS (SERIES K) SHOULD BE USED UNTIL EXISTING STOCK IS DEPLETED.
   ~~MONEL RIVETS IDENTIFIED BY M INACTIVE FOR DESIGN AFTER 1 FEBRUARY 1960. USE RIVETS IDENTIFIED BY ML (MONEL, SILVER PLATED).~~

8. FOR DESIGN FEATURE PURPOSES, THIS STANDARD TAKES PRECEDENCE OVER PROCUREMENT DOCUMENTS REFERENCED HEREIN. REFERENCED DOCUMENTS SHALL BE OF THE ISSUE IN EFFECT ON DATE OF INVITATIONS FOR BID.

PREPARING ACTIVITY: NAVY — AS
CUSTODIANS ARMY — AR NAVY —
AIR FORCE — 99 DLA —

MILITARY SPECIFICATION SHEET
TITLE RIVET, BLIND, STRUCTURAL PULL STEM, SELF-PLUGGING.

SPECIFICATION SHEET NUMBER
MS20600
10 AUG 92
REV J
SUPERSEDING

FORM APPROVED
OMB NO 0704-0

Ⓙ TABLE VI. INTERCHANGEABILITY

INACTIVE PART NUMBERS		SUBSTITUTE PART NUMBERS	
MS20604			
MS20604	AD3E	MS20600	
	AD4E		AD4W
	AD5E		AD5W
	AD6E		AD6W
	AD8E		AD8W
	B3E		
	B4E		B4W
	B5E		B5W
	B6E		B6W
	B8E		B8W
	ML3E		—
	MP3E		—
	M3E		—
	ML4E		MP4W
	MP4E		MP4W
	M4E		M4W
	ML5E		MP5W
	MP5E		MP5W
	M5E		M5W
	ML6E		MP6W
	MP6E		MP6W
	M6E		M6W
	ML8E		MP8W
	MP8E		MP8W
MS20604	M8E	MS20600	M8W

CORRESPONDING GRIP NUMBERS ARE DIRECTLY INTERCHANGEABLE.

PREPARING ACTIVITY NAVY — AS
CUSTODIANS. ARMY — AR NAVY —
AIR FORCE — 99 DLA —
REVIEW ARMY—ER, AV, MI NAVY—SH DLA — IS
USER. AIR FORCE 82

MILITARY SPECIFICATION SHEET
TITLE RIVET, BLIND, STRUCTURAL PULL STEM, SELF-PLUGGING, PROTRUDING HEAD, TYPE II

SPECIFICATION SHEET NUMBER
MS20600
10 AUG 92
REV J
SUPERSEDING
MS20600 REV H 11 DEC 89