FED SUP CLASS
5325

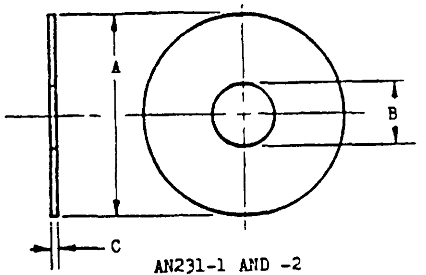

AN231-1 AND -2

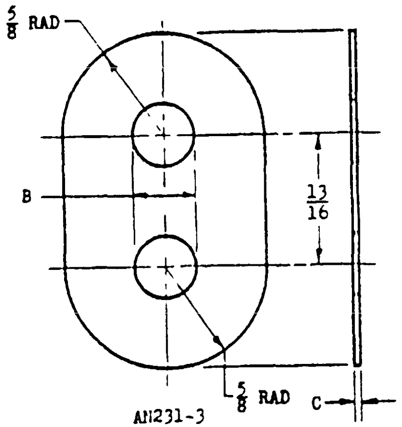

AN231-3

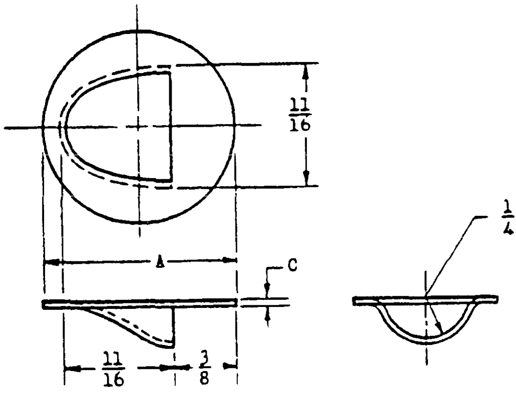

AN231-4

④

AN PART NUMBERS		A DIA	B DIA	C ±.0025	WEIGHT EST LB
CELLULOSE ACETATE BUTYRATE	~~CELLULOSE NITRATE~~				
AN231-1	~~AN231A1~~	1-1/4	3/8	.0200	.0008
AN231-2	~~AN231A2~~	3/4	5/16	.0200	.0002
AN231-3	~~AN231A3~~	-	3/8	.0200	.0015
AN231-4	~~AN231A4~~	1-3/16	-	.0325	.0018

MATERIAL: CELLULOSE ACETAGE BUTYRATE, CLEAR (COLORLESS). FOR CELLULOSE ACETATE BUTYRATE DOPED FABRIC.

④ ~~CELLULOSE NITRATE, COLOR LIGHT BLUE FOR CELLULOSE NITRATE DOPED FABRIC~~

DIMENSIONS IN INCHES. UNLESS OTHERWISE SPECIFIED. TOLERANCE FRACTIONS ±1/64

④ INTERCHANGEABILITY RELATIONSHIP PARTS CODED WITH DASH (-) ARE UNIVERSALLY SUBSTITUTIVE FOR PARTS CODED "A" WITH THE SAME DASH NUMBER.

④ PARTS CODED A CANCELED AND INACTIVE FOR DESIGN AFTER 11 JULY 1969. USE -1, 2, 3 OR 4.

APPROVED 30 Dec 43 REVISED ① 22 Mar 44 ② 8 Oct 45 ③ 15 Oct 48 ④ 11 Jul 69

P.A. Navy - AS Other Cust USAF-82	**AIR FORCE–NAVY AERONAUTICAL STANDARD** GROMMET-DRAINAGE, PLASTIC	AN231
Procurement Specification NONE	SUPERSEDES	SHEET 1 OF 1

DD FORM 1 SEP 57 672

PREVIOUS EDITIONS OF THIS FORM ARE OBSOLETE

☆ U. S. GOVERNMENT PRINTING OFFICE: 1969-393-064/5-938

NOTES TO PRINTER REDUCE BORDER TO 6-27/32x9-3/4 PRINT LEFT BORDER-LINE ONE INCH FROM LEFT EDGE OF 8x10-1/2 SHEET PRINT BOTTOM BORDER LINE 3/8 INCH FROM BOTTOM EDGE OF 8x10-1/2 SHEET. SIGNATURE FORM NOT TO BE INCLUDED ON 8x10-1/2 SHEET

		DATE
DRAWN BY		
TYPED BY		
CHECKED BY		

GPO 930808

NOTICE—When Government drawings, specifications, or other data are used for any purpose other than in connection with a definitely related Government procurement operation, the United States Government thereby incurs no responsibility, nor any obligation whatsoever; and the fact that the Government may have formulated, furnished, or in any way supplied the said drawings, specifications, or other data is not to be regarded by implication or otherwise as in any manner licensing the holder or any other person or corporation, or conveying any rights or permission to manufacture, use or sell any patented invention that may in any way be related thereto.

AIR FORCE AIR FORCE

NOTE: This drawing was approved by joint action of the [redacted] and Navy Departments as the [redacted]-Navy standard for this product. This drawing supersedes all antecedent standard drawings for the same product and shall become effective for the procurement of aeronautical supplies or for use in new design, not later than six months after the latest date of approval shown. It may be put into effect, however at an earlier date after promulgation.

Source: https://assist.dla.mil -- Downloaded: 202610-26T14:14Z
Check the source to verify that this is the current version before use.