THIS SPECIFICATION IS APPROVED FOR USE BY ALL DEPARTMENTS AND AGENCIES OF THE DEPARTMENT OF DEFENSE.
THE REQUIREMENTS FOR ACQUIRING THE PRODUCT(S) DESCRIBED HEREIN SHALL CONSIST OF THIS SPECIFICATION SHEET AND THE ISSUE OF THE FOLLOWING SPECIFICATION LISTED IN THAT ISSUE OF THE DODISS SPECIFIED IN THE SOLICITATION: FF-W-84

Form Approved
OMB No. 0704-0188

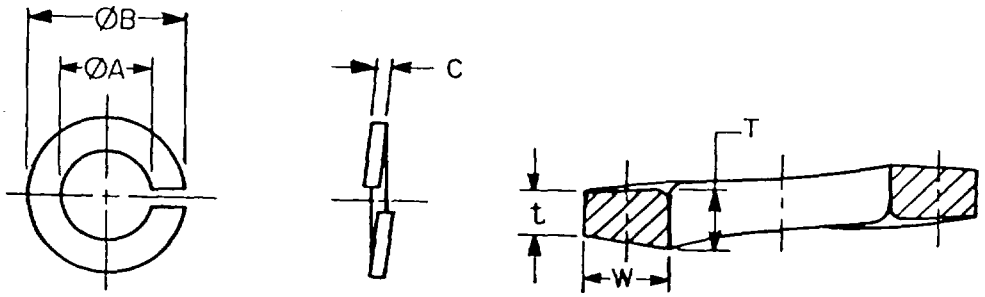


TABLE I. DASH NUMBERS AND DIMENSIONS

NOMINAL SIZE		CARBON STEEL CAD	CARBON STEEL PHOS	CRES 300	ØA ID MIN	ØA ID MAX	ØB OD MAX	W WIDTH MIN	C THICKNESS $\frac{T+t}{2}$ MIN	
		DASH NUMBERS 1/								
NO.0	(.060)	1	21	41	.062	.068	.112	.018	.018	(D)
~~NO.1~~	~~(.073)~~	~~2~~	~~22~~	~~42~~	~~.075~~	~~.080~~	~~.112~~	~~.016~~	~~.016~~	
NO.2	(.086)	3	23	43	.088	.094	.146	.022	.022	(D)
~~NO.3~~	~~(.099)~~	~~4~~	~~24~~	~~44~~	~~.102~~	~~.108~~	~~.151~~	~~.018~~	~~.018~~	
NO.4	(.112)	5	25	45	.114	.120	.173	.022	.022	
~~NO.5~~	~~(.125)~~	~~6~~	~~26~~	~~46~~	~~.128~~	~~.134~~	~~.202~~	~~.030~~	~~.030~~	
NO.6	(.138)	7	27	47	.141	.148	.216	.030	.030	
NO.8	(.164)	8	28	48	.167	.174	.267	.042	.047	
NO.10	(.190)	9	29	49	.193	.200	.294	.042	.047	
1/4	(.250)	10	30	50	.252	.260	.365	.047	.078	
5/16	(.312)	11	31	51	.314	.322	.460	.062	.093	
3/8	(.375)	12	32	52	.377	.385	.553	.076	.125	
7/16	(.438)	13	33	53	.440	.450	.647	.090	.140	
1/2	(.500)	14	34	54	.502	.512	.737	.103	.172	
5/8	(.625)	15		55	.628	.640	.923	.125	.203	
3/4	(.750)	16			.753	.765	1.111	.154	.218	
7/8	(.875)	17			.878	.890	1.296	.182	.234	
1	(1.000)	18			1.003	1.015	1.483	.208	.250	

1/ SEE NOTE 2

(D) DENOTES CHANGES

INCH - POUND

PREPARING ACTIVITY: ARMY-AR
CUSTODIANS: ARMY- AR NAVY- AS
AIR FORCE- 99 DLA-
REVIEW: AV,SH,82,IS,NS
USER: AT,GL,ME,MC,OS,YD
PROJECT NUMBER: 5310-1823

MILITARY SPECIFICATION SHEET

TITLE
WASHER, LOCK - HELICAL SPRING, HI - COLLAR

SPECIFICATION SHEET NUMBER
MS51848D 13 AUGUST 1991
SUPERSEDING
MS51848C 30 MARCH 1990 (SEE NOTE 3)
AMSC- N/A FSC - 5310

DISTRIBUTION STATEMENT
A. Approved for public release; distribution is unlimited.

DD Form 672 [illegible] 83

Source: https://assist.dla.mil -- Downloaded: 2026-10-23T18:10Z
Check the source to verify that this is the current version before use.

GPO: 1989 606 945

THE REQUIREMENTS FOR ACQUIRING THE PRODUCT(S) DESCRIBED HEREIN SHALL CONSIST OF THIS SPECIFICATION SHEET AND THE ISSUE OF THE FOLLOWING SPECIFICATION LISTED IN THAT ISSUE OF THE DODISS SPECIFIED IN THE SOLICITATION: FF-W-84

THIS SPECIFICATION IS APPROVED FOR USE BY ALL DEPARTMENTS AND AGENCIES OF THE DEPARTMENT OF DEFENSE.

Form Approved
OMB No. 0704-0188

REQUIREMENTS:

1. MATERIAL:

   a. STEEL, CARBON, GRADE 1060 (UNS G10600) THRU 1080 (UNS G10800).

   b. CORROSION-RESISTANT STEEL (NON-MAGNETIC) WASHERS SHALL BE TYPE 316 (UNS S31600) THRU 1/4" AND TYPE 300 SERIES (UNS S30200 TO UNS S31600) FOR ALL OTHER SIZES.

2. PROTECTIVE FINISH:

   a. CARBON STEEL WASHERS:

      1. CADMIUM PLATING SHALL BE IN ACCORDANCE WITH QQ-P-416, TYPE II, CLASS 2, OR MIL-C-81562, TYPE II, CLASS 2 (NO SUBSTITUTES ALLOWED).

      2. PHOSPHATE COATING SHALL BE IN ACCORDANCE WITH MIL-P-16232, TYPE Z, CLASS 2.

   b. CORROSION-RESISTANT STEEL WASHERS:

      1. PASSIVATION SHALL BE IN ACCORDANCE WITH QQ-P-35.


3. HARDNESS:

   a. CARBON STEEL WASHERS SHALL HAVE A HARDNESS OF 38 TO 46HRC.

   b. CORROSION-RESISTANT STEEL WASHERS TYPE 420 (UNS S42000) SHALL HAVE A HARDNESS OF 45-53HRC, AND TYPE 300 (UNS S3XXXX) SERIES WASHERS SHALL HAVE A HARDNESS OF 35-43HRC.

4. PART NUMBER: THE PART NUMBER SHALL CONSIST OF THE BASIC SPECIFICATION SHEET NUMBER FOLLOWED BY A DASH NUMBER TAKEN FROM TABLE I.

EXAMPLE: MS51848-1

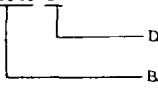

MS51848-1 INDICATES - WASHER, LOCK-HELICAL SPRING, HI-COLLAR; NO. 0 (.060) NOMINAL SIZE; CARBON STEEL; CADMIUM PLATED.

NOTES:

1. ALL DIMENSIONS ARE IN INCHES.
2. DASH NUMBERS 2, 4, 6, 22, 24, 26, 42, 44 AND 46 ARE CANCELLED AFTER 28 FEBRUARY 1973.
3. MS51848 SUPERSEDES NAS1676 IN PART, SEE TABLE II.
4. IN THE EVENT OF A CONFLICT BETWEEN THE TEXT OF THIS STANDARD AND THE REFERENCES CITED HEREIN, THE TEXT OF THIS STANDARD SHALL TAKE PRECEDENCE.
5. REFERENCED GOVERNMENT (OR NON-GOVERNMENT) DOCUMENTS OF THE ISSUE LISTED IN THAT ISSUE OF THE DEPARTMENT OF DEFENSE INDEX OF SPECIFICATIONS AND STANDARDS (DoDISS) SPECIFIED IN THE SOLICITATION FORM A PART OF THIS STANDARD TO THE EXTENT SPECIFIED HEREIN.

TABLE II. INTERCHANGEABILITY

THE FOLLOWING NAS 1676 PART NUMBERS ARE SUPERSEDED AFTER 28 FEBRUARY 1973 BY THE MS51848 PART NUMBERS SHOWN BELOW. ONLY THE SUPERSEDING MS51848 PART NUMBERS SHALL BE USED FOR NEW DESIGN.

PART NUMBER		PART NUMBER		PART NUMBER	
NAS 1676	SUPERSEDING MS51848	NAS 1676	SUPERSEDING MS51848	NAS 1676	SUPERSEDING MS51848
-0	1	-716	13	C6	47
-2	3	-816	14	C8	48
-4	5	-1016	15	C10	49
-6	7	-1216	16	C416	50
-8	8	-1416	17	C516	51
-10	9	-1616	18	C616	52
-416	10	C0	41	C716	53
-516	11	C2	43	C816	54
-616	12	C4	45	C1016	55

PREPARING ACTIVITY: ARMY-AR
CUSTODIANS: ARMY- AR NAVY- AS
AIR FORCE-99 DLA-
REVIEW: AV,SH,82,IS,NS
USER: AT,GL,ME,MC,OS,YD
PROJECT NUMBER: 5310-1823

MILITARY SPECIFICATION SHEET

TITLE

WASHER, LOCK - HELICAL SPRING, HI - COLLAR

SPECIFICATION SHEET NUMBER

MS51848D 13 AUGUST 1991

SUPERSEDING
MS51848C 30 MARCH 1990 (SEE NOTE 3)

AMSC- N/A FSC - 5310

DISTRIBUTION STATEMENT

A. Approved for public release; distribution is unlimited.

Source: https://assist.dla.mil -- Downloaded: 2026-10-23T18:10Z
Check the source to verify that this is the current version before use.

DD Form 672 MAY 88 PREVIOUS EDITIONS ARE OBSOLETE

GPO 1989 606 945